


T.36&37S. R.1&2E. W.M.

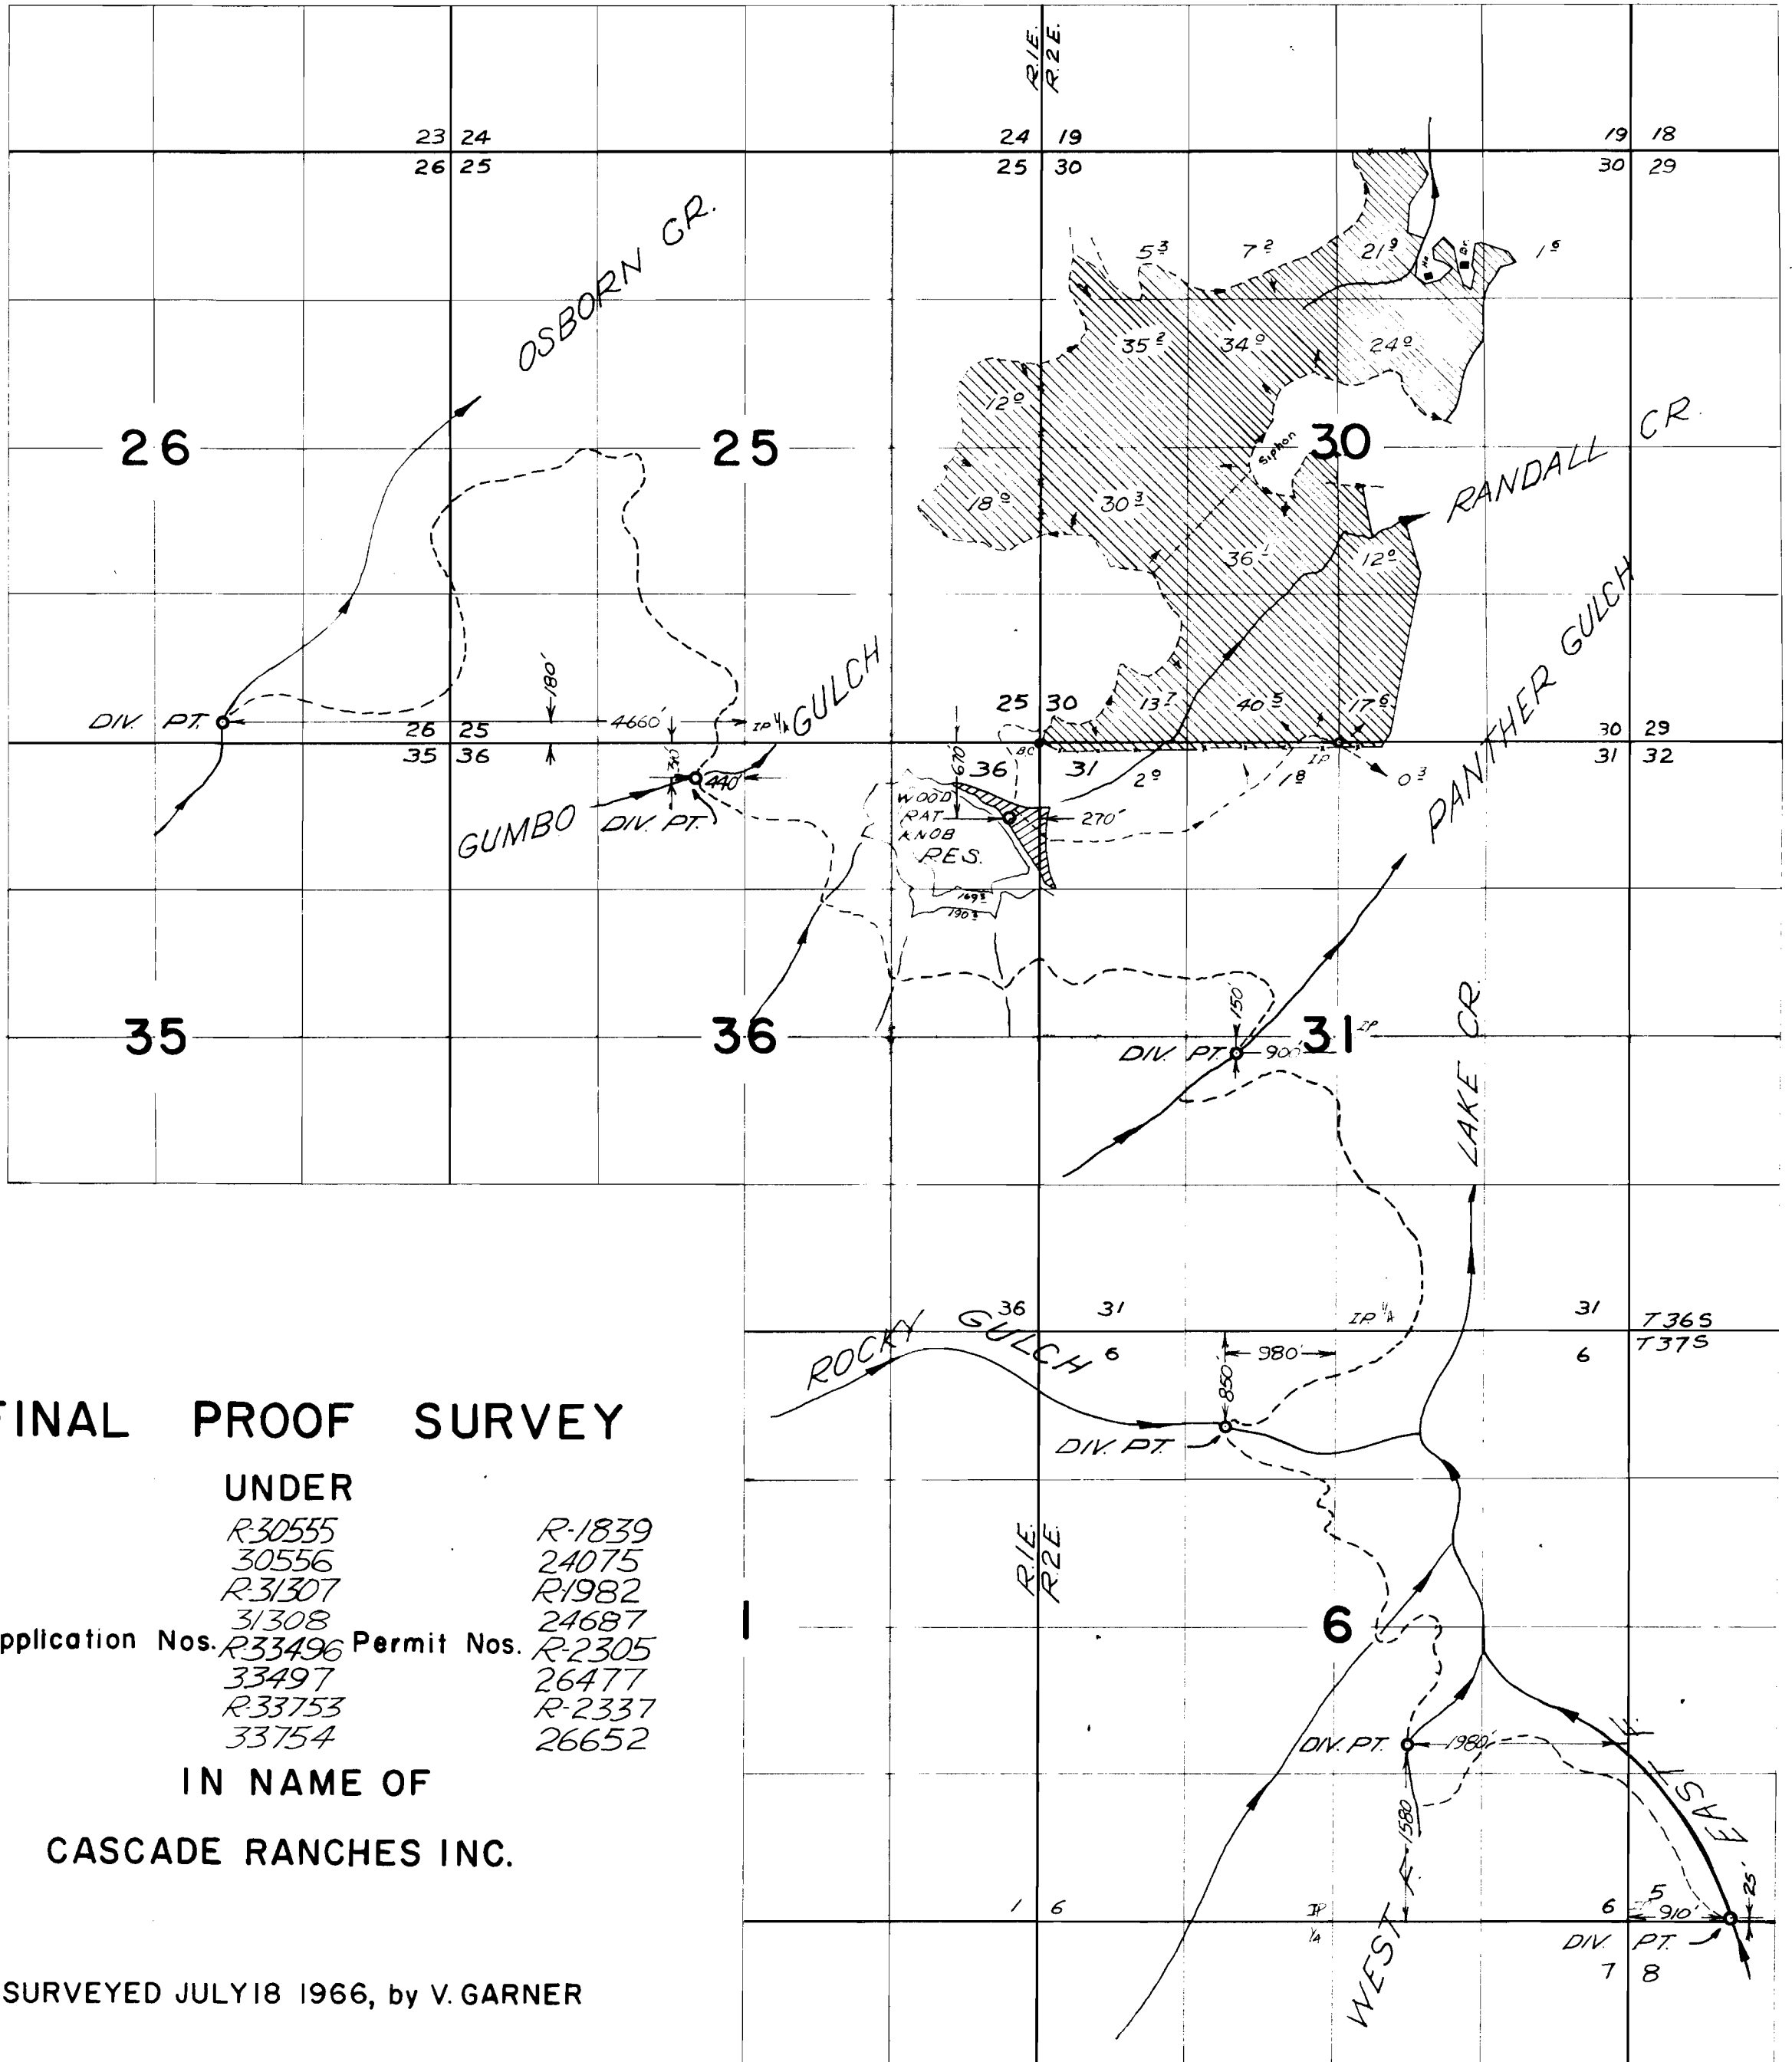

FINAL PROOF SURVEY

UNDER

R-30555	R-1839
30556	24075
R-31307	R-1982
31308	24687
Application Nos. R-33496	Permit Nos. R-2305
33497	26477
R-33753	R-2337
33754	26652

IN NAME OF
CASCADE RANCHES INC.

SURVEYED JULY 18 1966, by V. GARNER