


T. 26 S. R. 6 W. W.M.

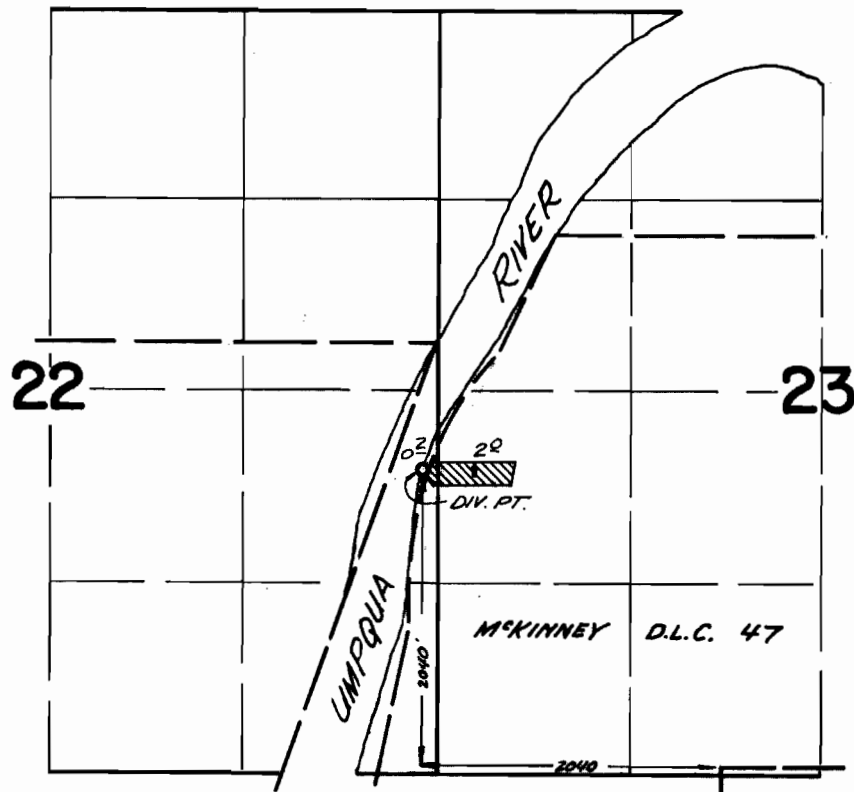

FINAL PROOF SURVEY
UNDER

Application No. 43366 Permit No. 32411
IN NAME OF

JOSEPH H. and DORIS K. BEDELL

Surveyed Oct 1 1968, by V. Gardner