


T. 33 S. R. 1 W. W. M.

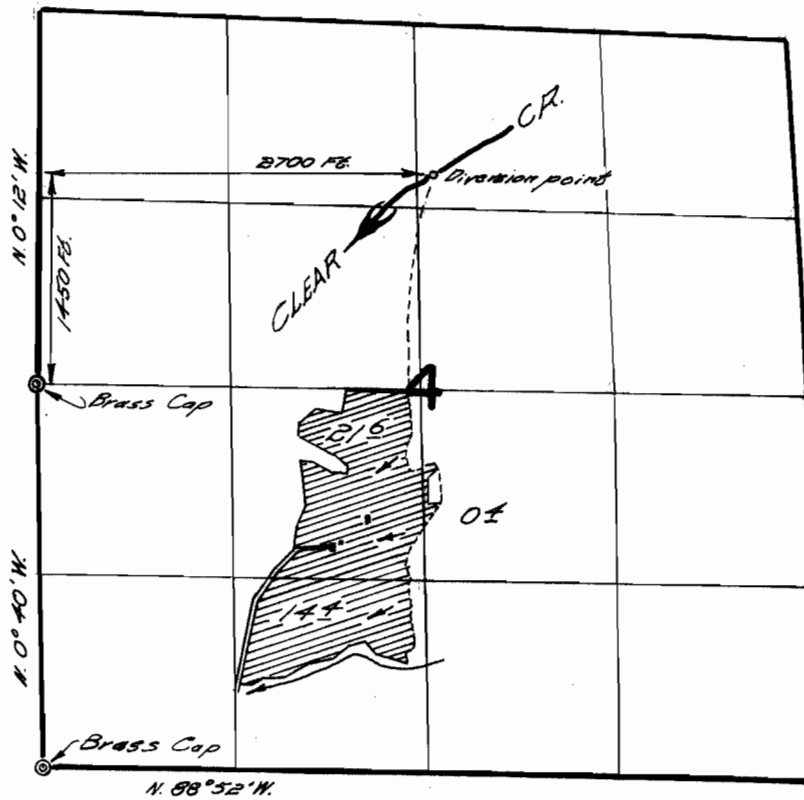

FINAL PROOF SURVEY UNDER

Application No. 39878. Permit No. 29775.
IN NAME OF

CHESTER RAY LONGBRAKE

Surveyed May 17, 1967, by *W. J. Ruppert*
March 11, 1969 by *David C. Hendrix*