


T. 34 S. R. 1 W. W. M.

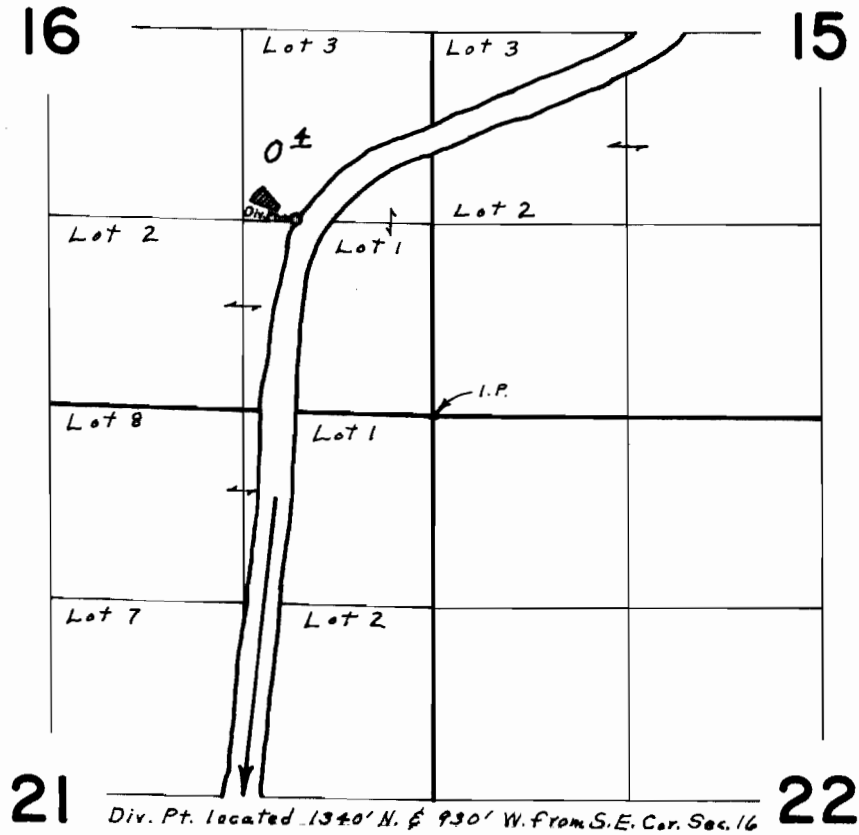

FINAL PROOF SURVEY
UNDER

Application No. ~~40304~~ Permit No. ~~30061~~...
IN NAME OF

J. R. & LOLLIE WEST

Surveyed *May 20, 1968*, by *L. E. Gould*...