


T. 36 S. R. 4 W. W. M.

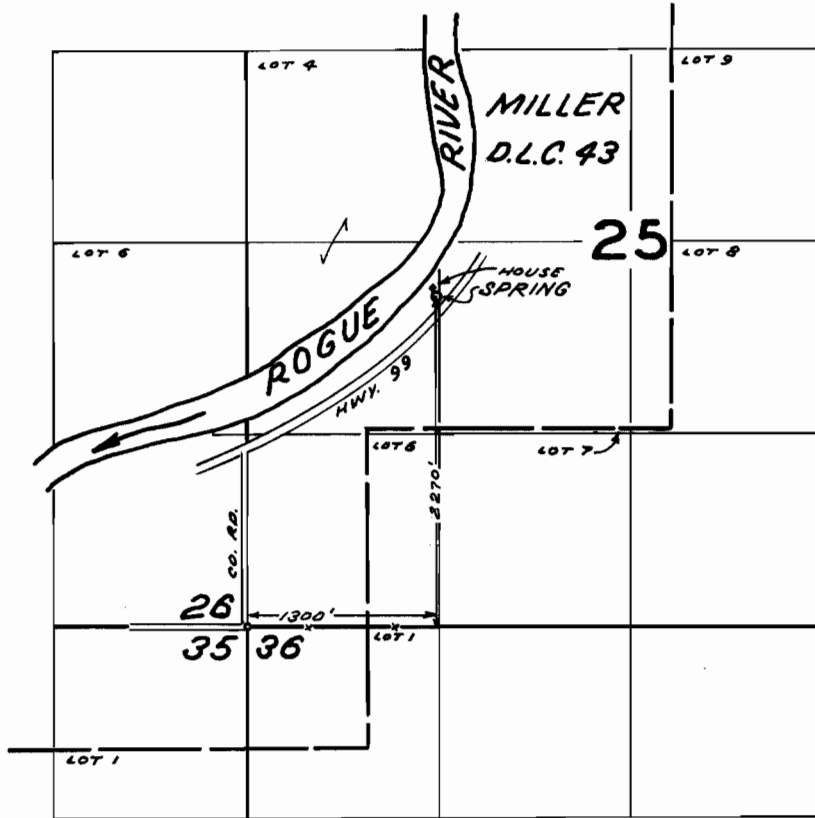

**FINAL PROOF SURVEY**  
UNDER

Application No. 41627 Permit No. 31070  
IN NAME OF

HAROLD M. AND AUDREY A. BREW

Surveyed JUN 11 1968, by V. GARNER