


T. 35 S. R. 4 W. W.M.

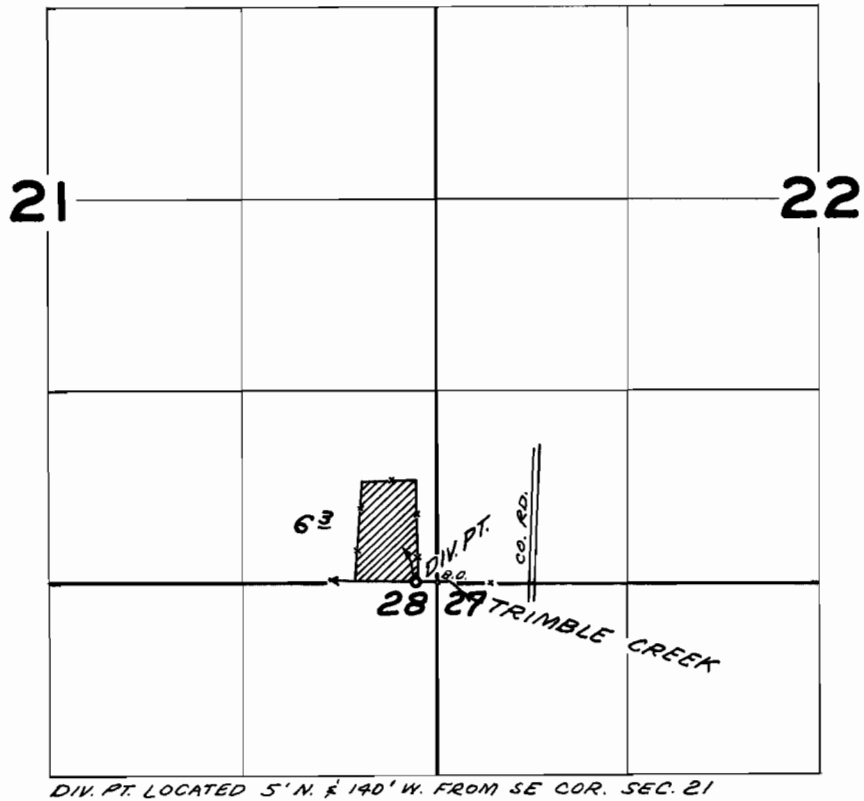

FINAL PROOF SURVEY
UNDER

Application No. 41659 Permit No. 31088
IN NAME OF

EUGENE L. AND ETHEL A. MARS

Surveyed JUN. 6 1968, by V. GARNER