


T. 35 S. R. 1 W. W.M.

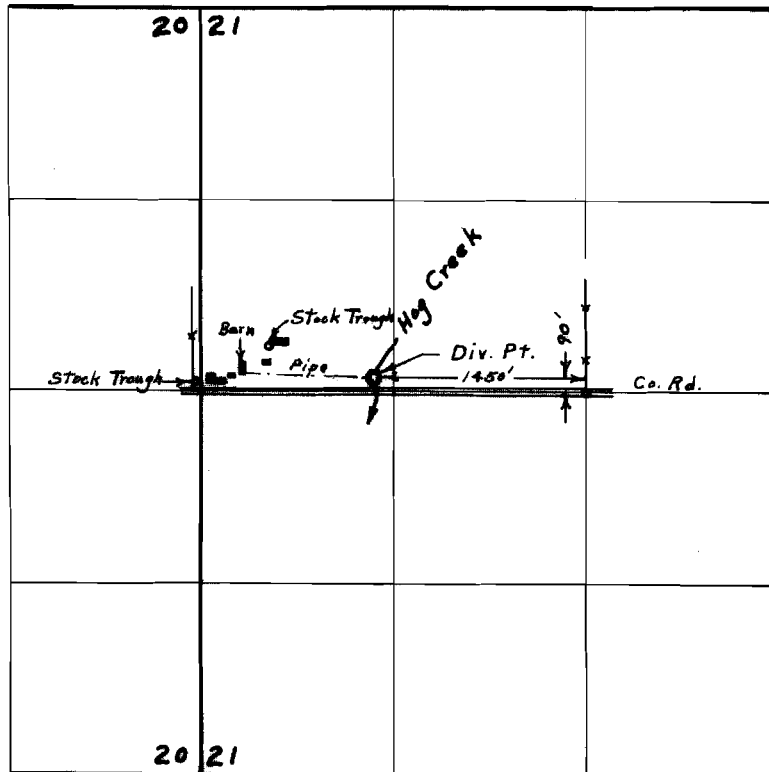

FINAL PROOF SURVEY UNDER

Application No. 42174 Permit No. 31560
IN NAME OF
ORAL W. TUCKER

Surveyed May 24, 1968, by L. E. Gould