


T. 35S.R.2 W.W.M.

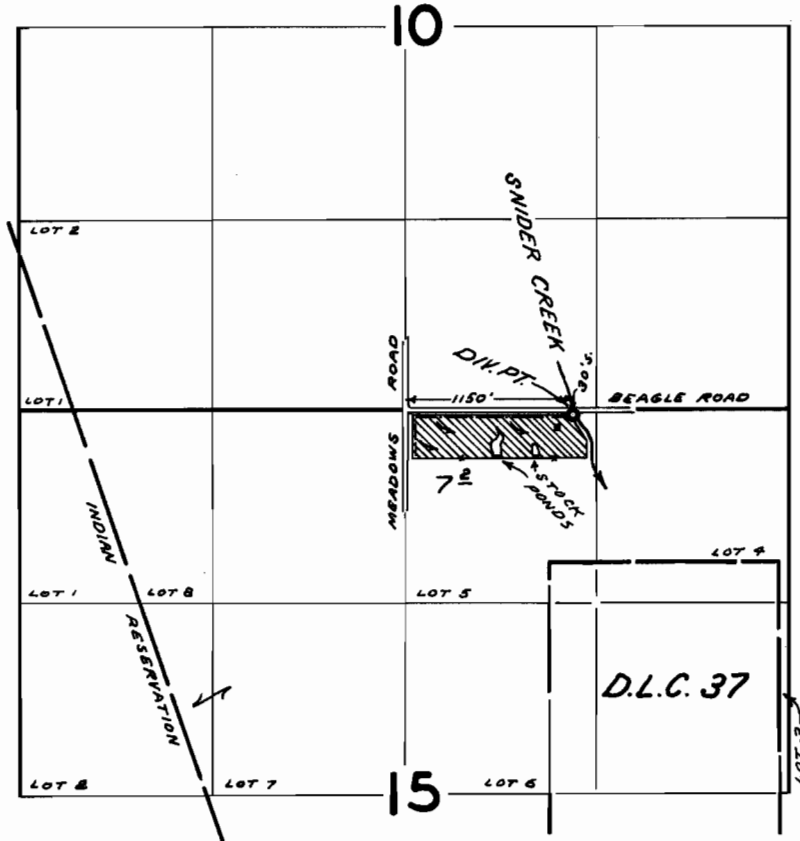

**FINAL PROOF SURVEY**  
UNDER

Application No. 42333 Permit No. 31648  
IN NAME OF

EARL COX

Surveyed JUN. 12 1968, by V. GARNER