


# T. 33 S. R. 2 E. W. M.

T. 32 S. R. 3 E. W. M.

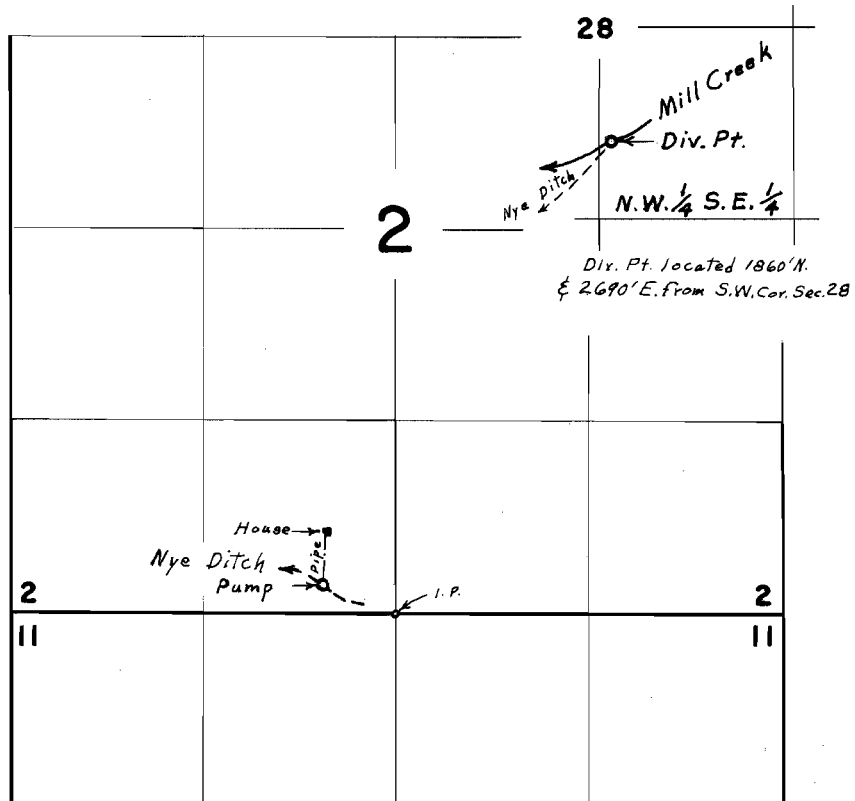

## FINAL PROOF SURVEY UNDER

Application No. 42870 Permit No. 32041  
IN NAME OF

WILLIAM LEONARD

Surveyed May 13, 1968, by L. E. Gould