


35908
76447
76495
T4837
N

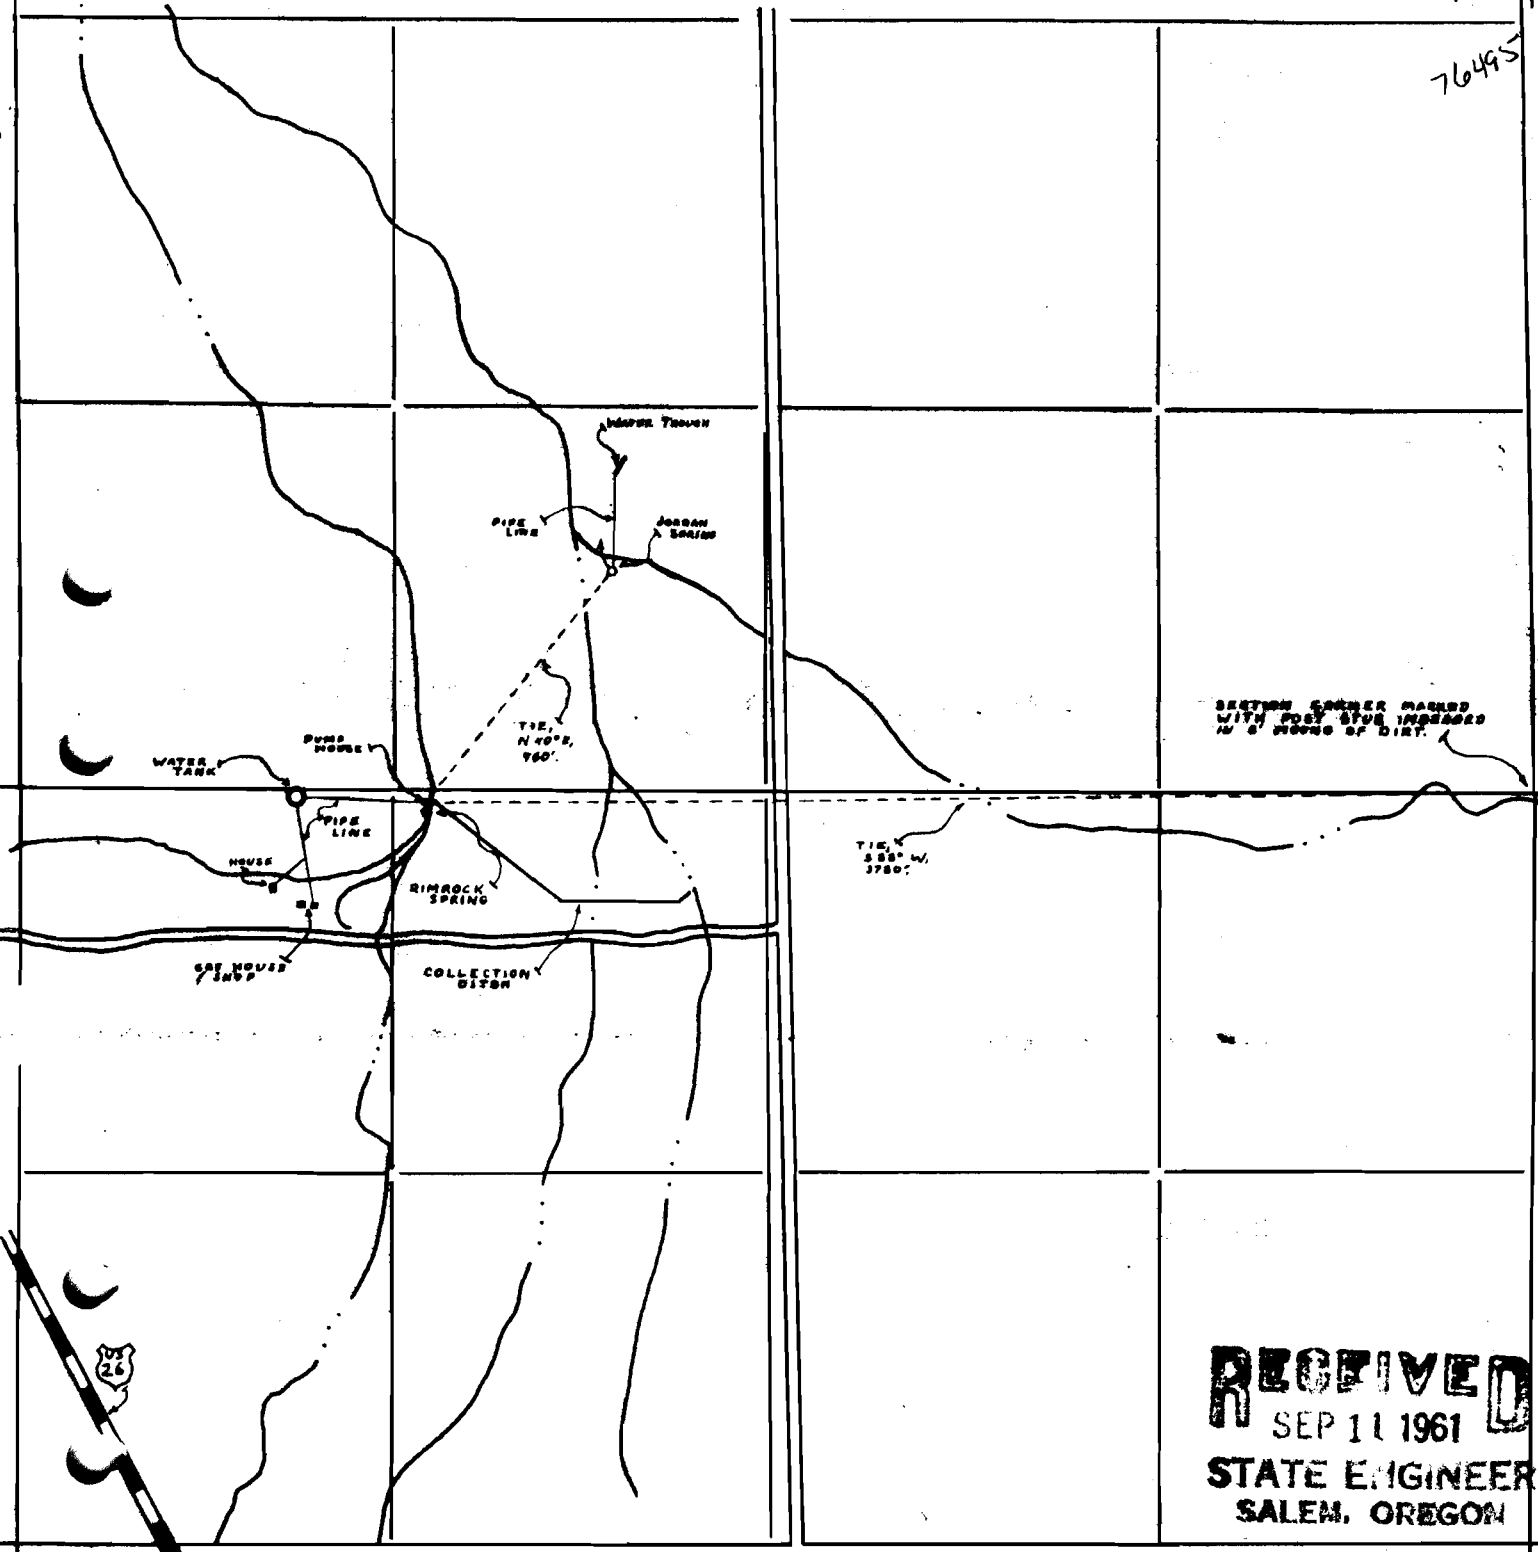

SECTION CORNER MARKED WITH POST STUB IMBEDDED IN 6" PIECE OF BIRT.

RECEIVED
SEP 11 1961
STATE ENGINEER
SALEM, OREGON

34

Application No. **35020**
Permit No. **27531**

CAMP SPRINGS

Drawn by: B Flint

Date 10-10-60

- LEGEND -

Intermittent Stream
Roads



SCALE - 8 IN = 1 MI

27531

STATE ENGINEER
SALEM, OREGON