


R 13 E

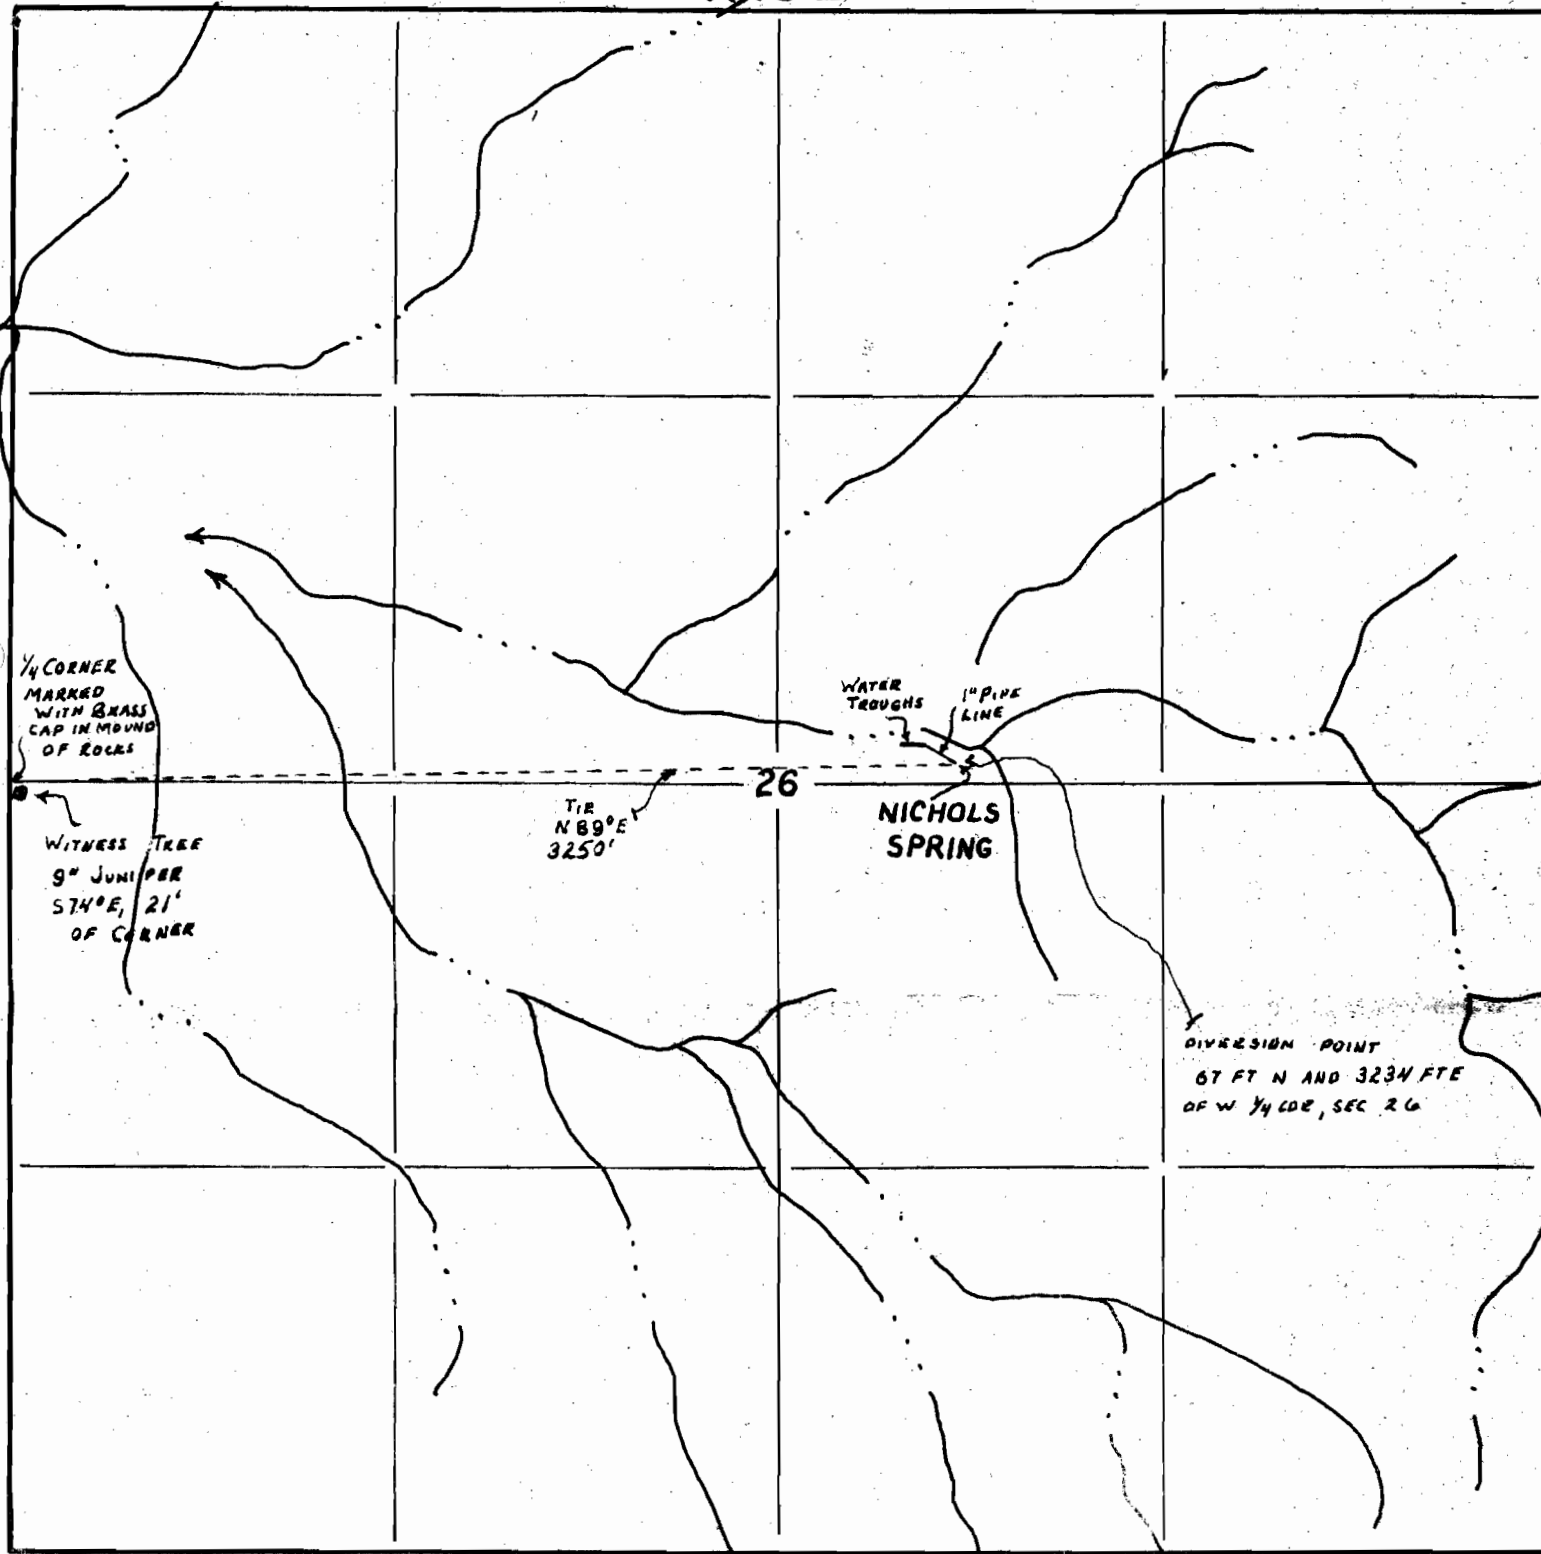


T 13 S

NICHOLS SPRING

LEGEND

INTERMITTENT STREAM

 

SCALE: 8 IN = 1 MI

Application No. 39421
Permit No.

B. FLINT

RECEIVED

JAN 21 1964

STATE ENGINEER
