


T.12S.R.9E.W.M.

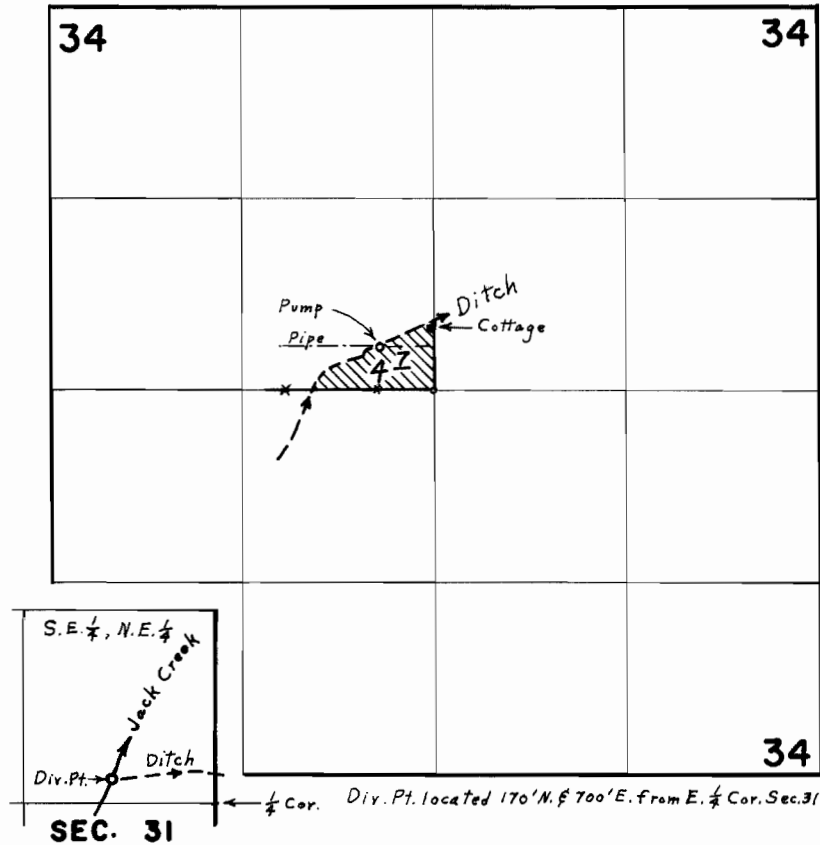

FINAL PROOF SURVEY UNDER

Application No. 38385 Permit No. 28603

IN NAME OF

ELEANOR BECHEN

Surveyed July 11, 1967, by L. E. Gould