


G2521

13
35972

T.26S.R.19E.W.M.

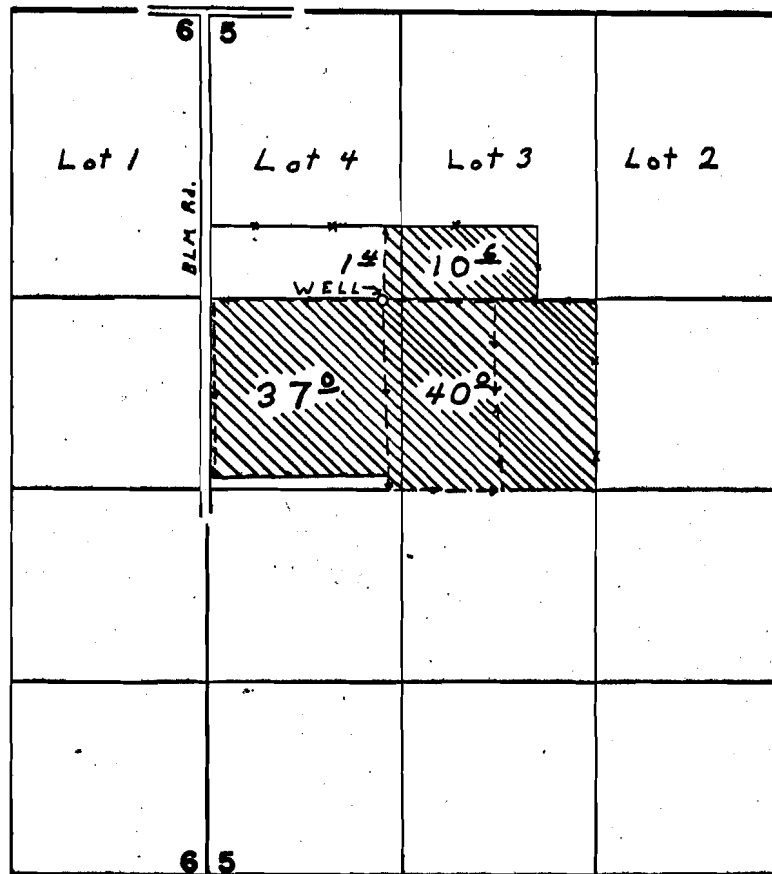

WELL LOCATED 1990' S & 1200' E FROM NW COR SEC 5

FINAL PROOF SURVEY
UNDER

Application No. G-2718 Permit No. G-2521
IN NAME OF

LYLE and/or HELEN DAMEWOOD

Surveyed AUG. 1. 1968, by L. E. GOULD