


T. 16 S. R. 4 W. W. M.

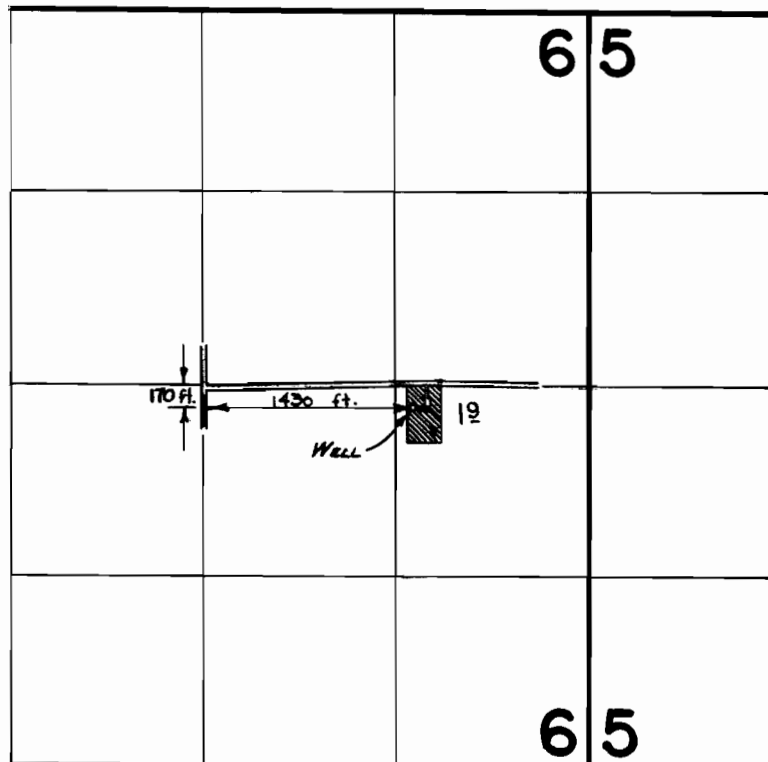

FINAL PROOF SURVEY
UNDER

Application No. ~~G-3658~~ Permit No. ~~G-3435~~
IN NAME OF

RONALD D. SANFORD

Surveyed Sept. 3 1968, by

[Signature]