


T. 17 S. R. 1 W. W.M.

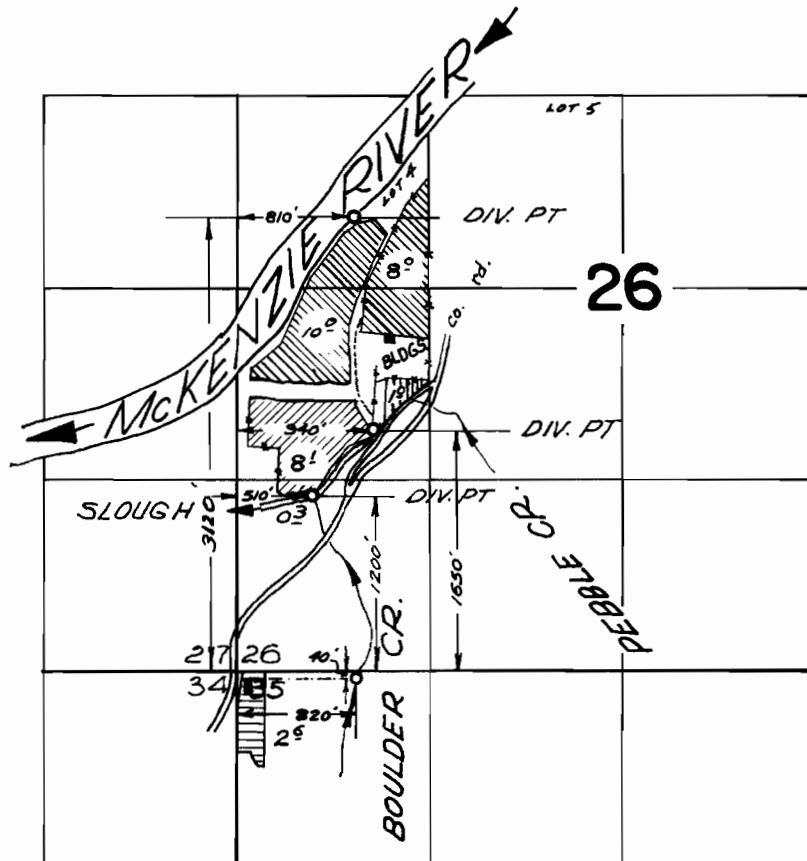

FINAL PROOF SURVEY UNDER

Application No. 35120... Permit No. 27491...
IN NAME OF

Mrs. N. G. BROWN

Surveyed May 12 1966, by V. GARNER