


# T. 21 S. R. 3 W. W. M.

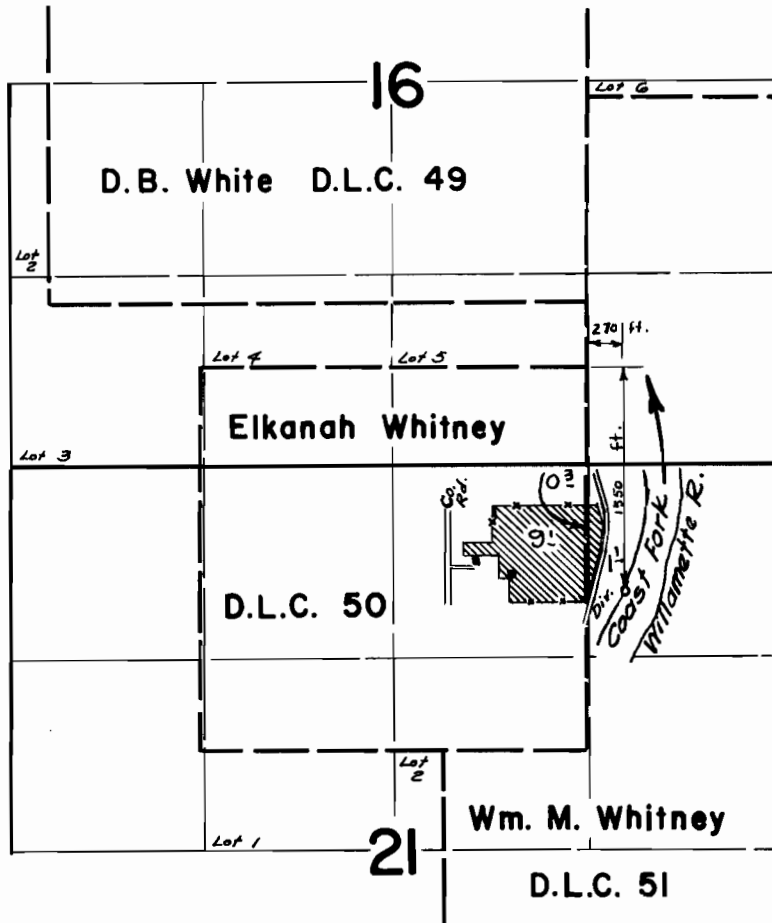

## FINAL PROOF SURVEY UNDER

Application No. 37982 Permit No. 28320  
IN NAME OF

JOHN LADD

Surveyed Sept. 10, 1968, by