


T. 20 S. R. 4 W.W.M.

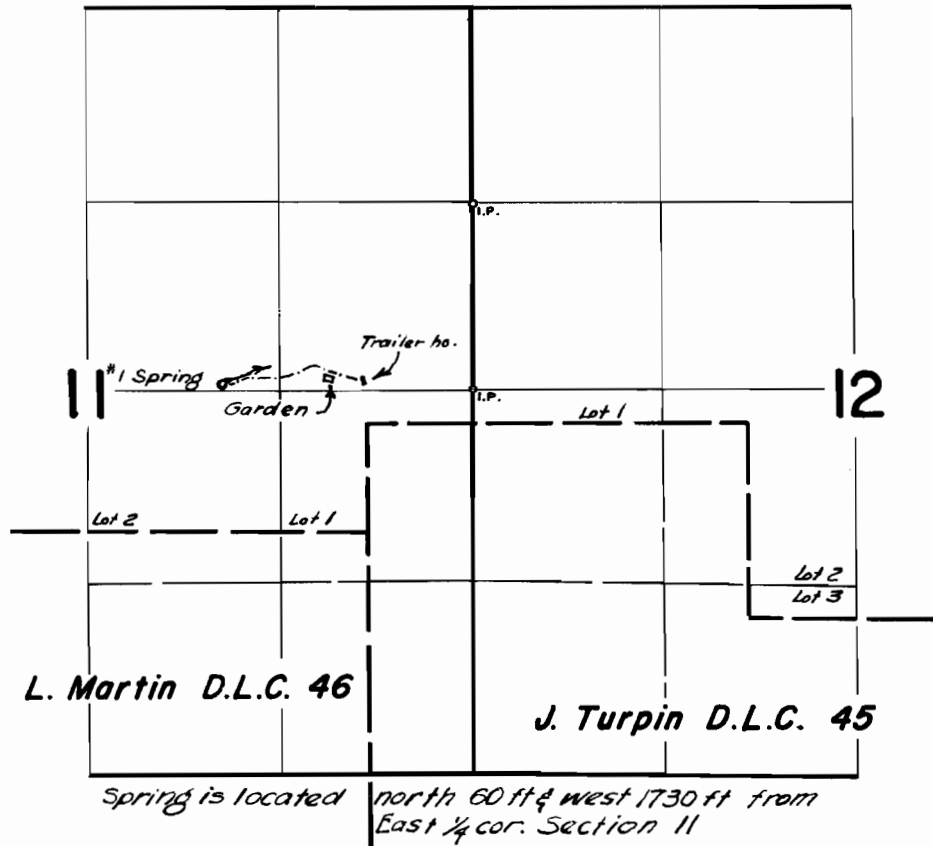

FINAL PROOF SURVEY
UNDER

Application No. 39863 Permit No. 29832...
IN NAME OF

E. D. ST. MARTIN

Surveyed Sept. 9 1968, by *R. Jackson*