


T.16 S. R.4 E.W.M.

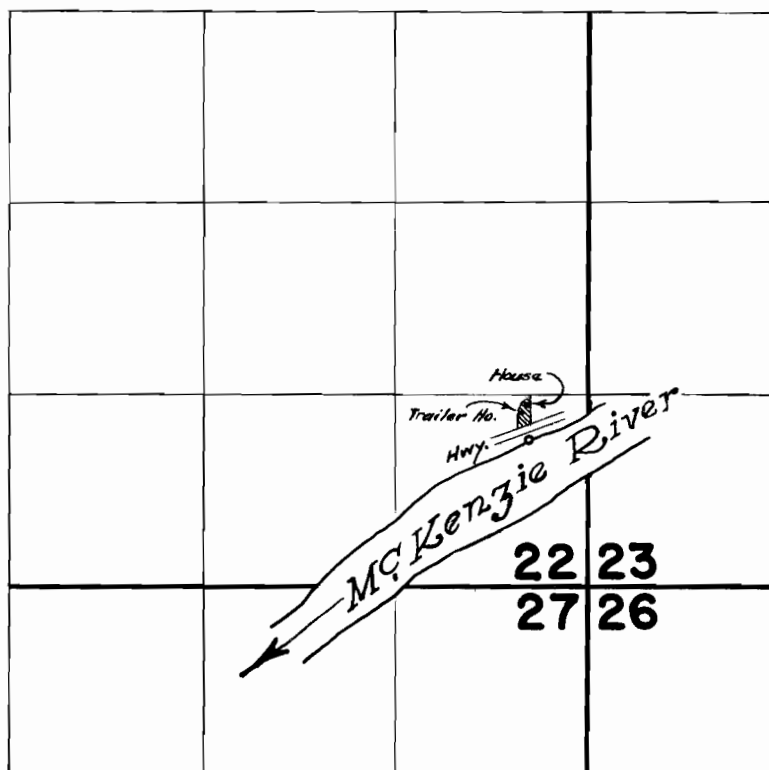

Div. Pt. is located South 310 ft. & West 430 ft. from N.E. cor. SE $\frac{1}{4}$ SE $\frac{1}{4}$

FINAL PROOF SURVEY
UNDER

Application No. 42762 Permit No. 31976
IN NAME OF

GEORGE BUCKLE

Surveyed Sept. 11, 1968, by *R. Jackson*