


T. 10 S. R. 11 W. W. M.

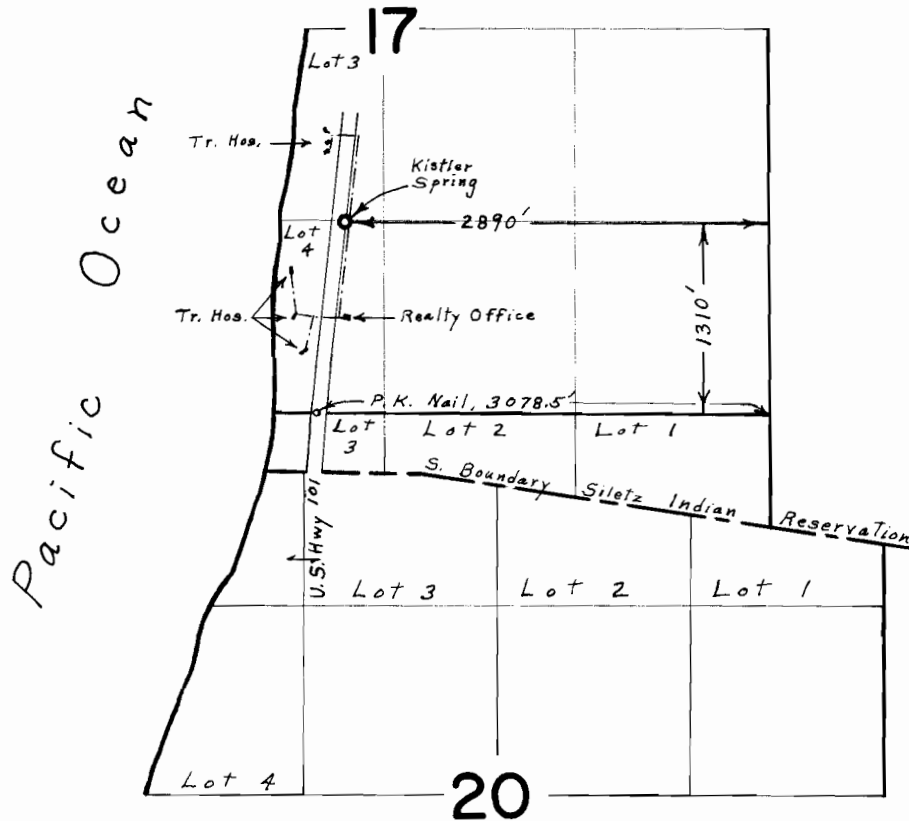

**FINAL PROOF SURVEY**  
UNDER

Application No. 37325 Permit No. 27804  
IN NAME OF

WILLS ENTERPRISES, INC.

Surveyed Sept. 27, 1967, by L. E. Gould