T.8 S.R.11 W.W.M.

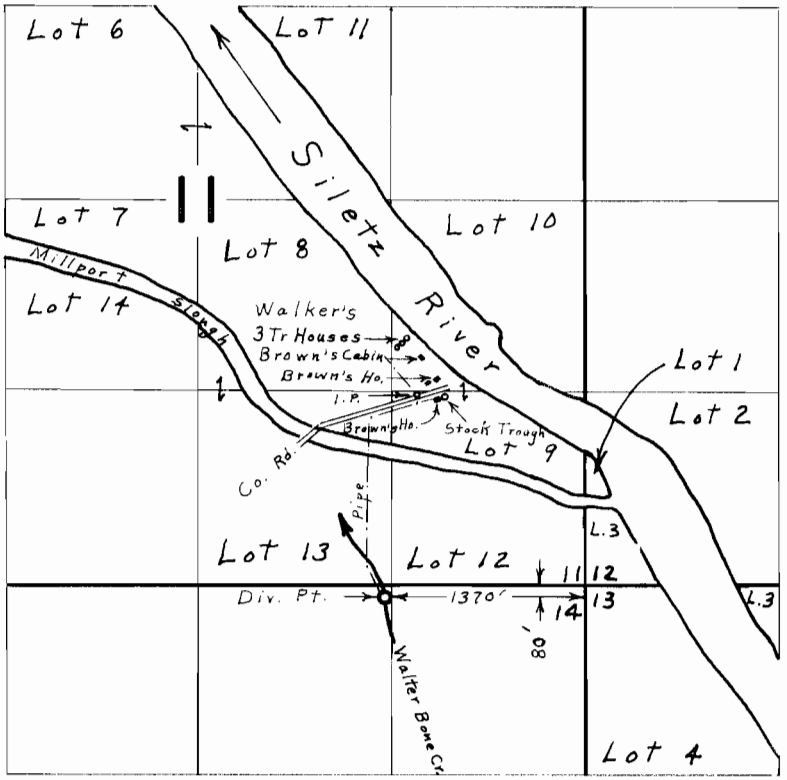

Note, pipe location is approximate

FINAL PROOF SURVEY
UNDER

Application No. 39016 Permit No. 29061
IN NAME OF

GEORGE A. BROWN & ROBERT B. WALKER

Surveyed Aug. 18, 1967, by L. E. Gould

1967 - V