
## T. 7 S. R. I W. W. M.

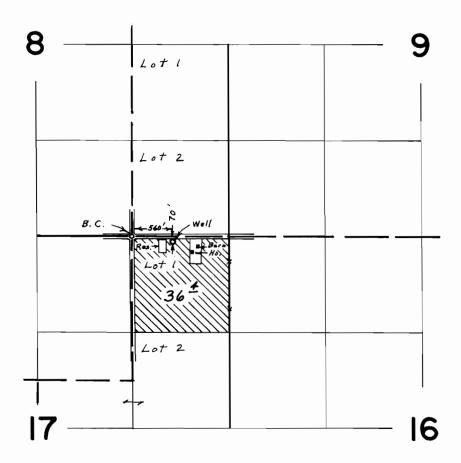

## FINAL PROOF SURVEY

Application No. G-2665 Permit No. G-247/ IN NAME OF

ARTHUR A. KUENZI

Surveyed June 20, 1968, by L. E. Gould