


T.8S.R.3W. W.M.

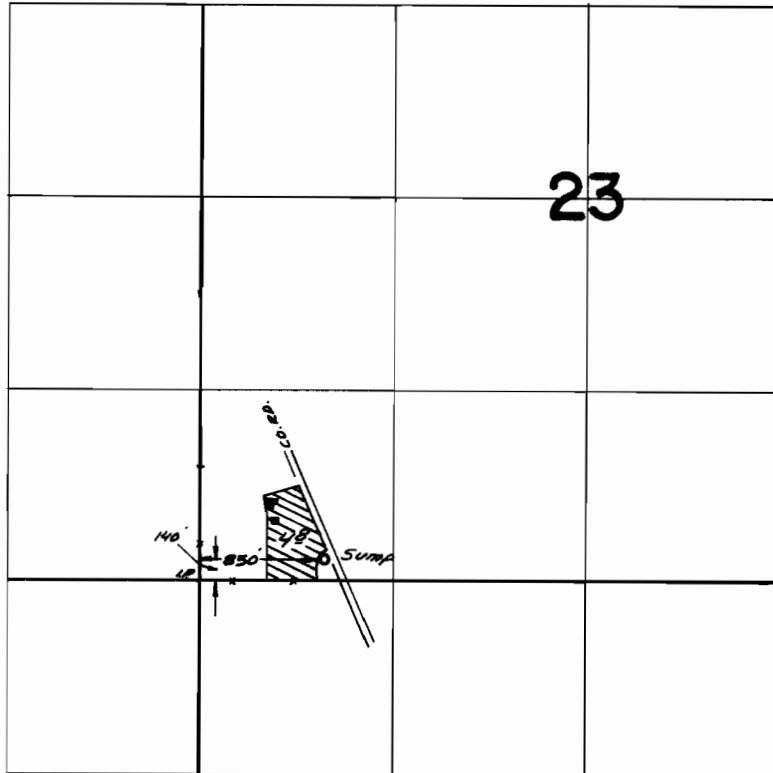

FINAL PROOF SURVEY
UNDER

Application No. *G-3115* Permit No. *G-2922*
IN NAME OF

BERT A. and LOUISE B. WALKER

Surveyed *April 26, 1968*, by *V. GARNER*