


T. 6 S. R. 1 W. W. M.

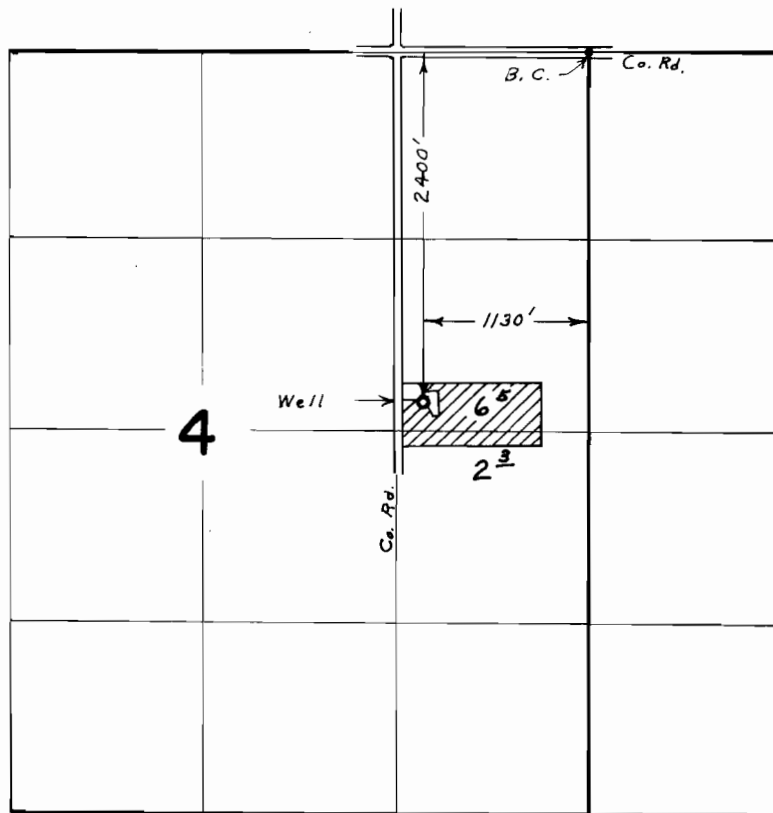

FINAL PROOF SURVEY UNDER

Application No. G-3458 Permit No. G-3096
IN NAME OF

IDA SINGLER

Surveyed April 9, 1968, by L. E. Gould.