


T. 6 S. R. 1 W. W. M.

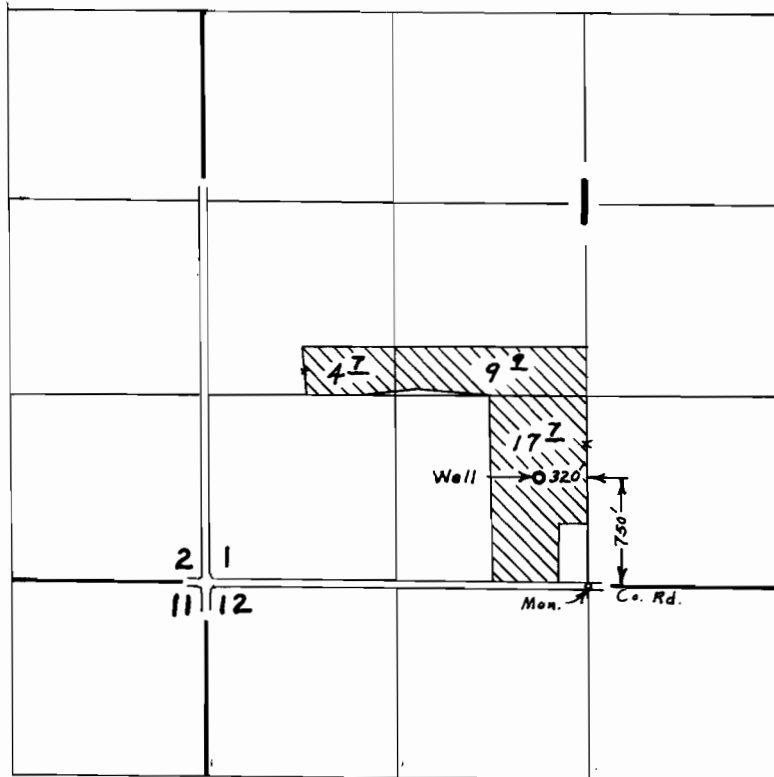

FINAL PROOF SURVEY UNDER

Application No. G-3351 Permit No. G-3145
IN NAME OF

MARK & AGNES PURDY

Surveyed April 8, 1968, by L. E. Gould