


# T. 6 S. R. 1 W. W. M.

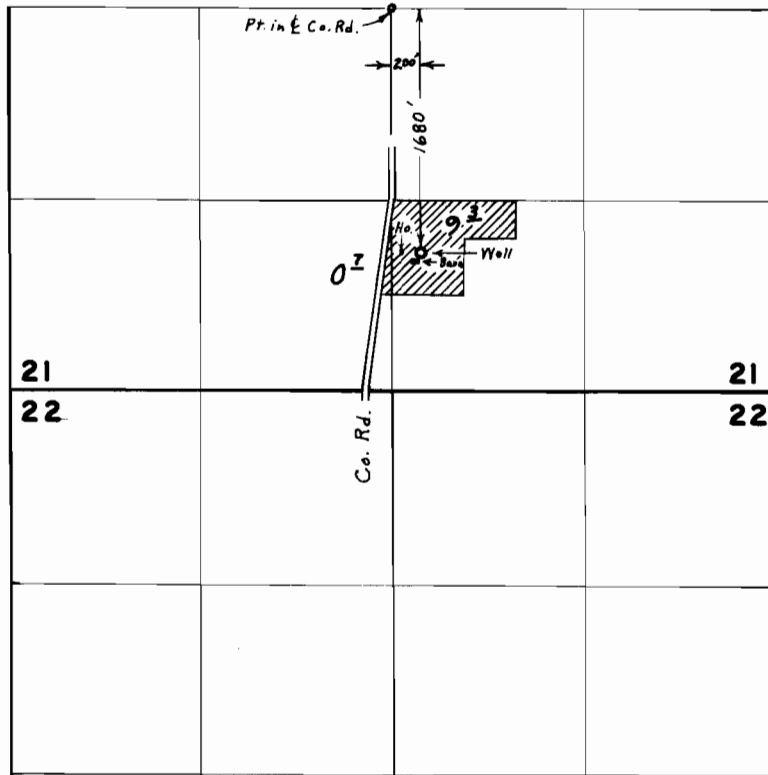

## FINAL PROOF SURVEY UNDER

Application No. ~~G-3492~~ Permit No. ~~G-3290~~  
IN NAME OF

HAROLD A. KLOSTER

Surveyed April 26, 1968, by L. E. Gould