


T.6 S.R.1 W.W.M.

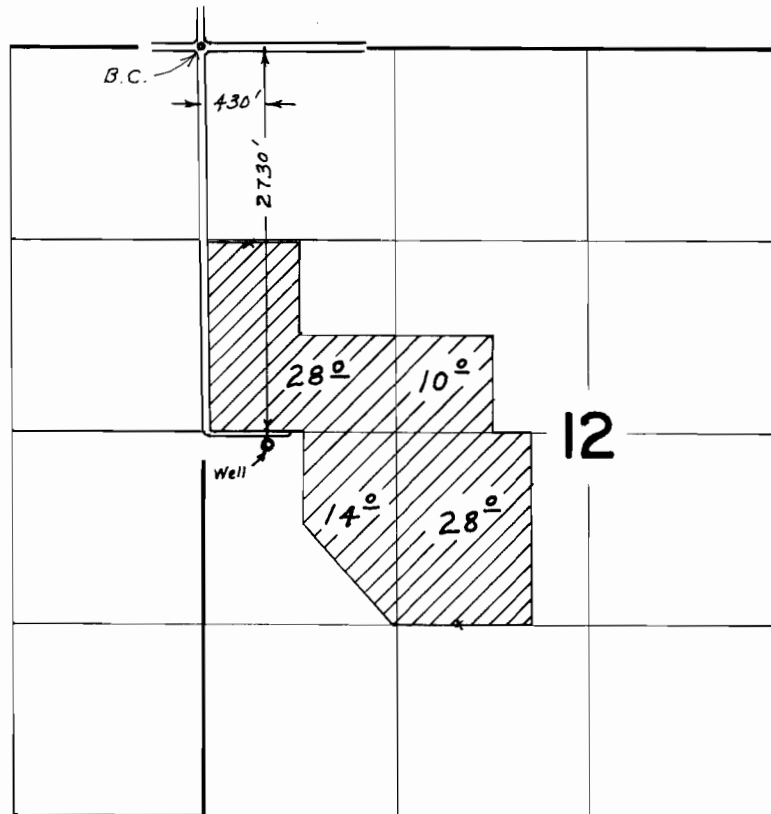

FINAL PROOF SURVEY
UNDER

Application No. G-3556 Permit No. G-3345
IN NAME OF

JOHN A. KLOFT

Surveyed April 11, 1968, by L. E. Gould