


T. 6 & 7 S. R. 1 E. W.M.

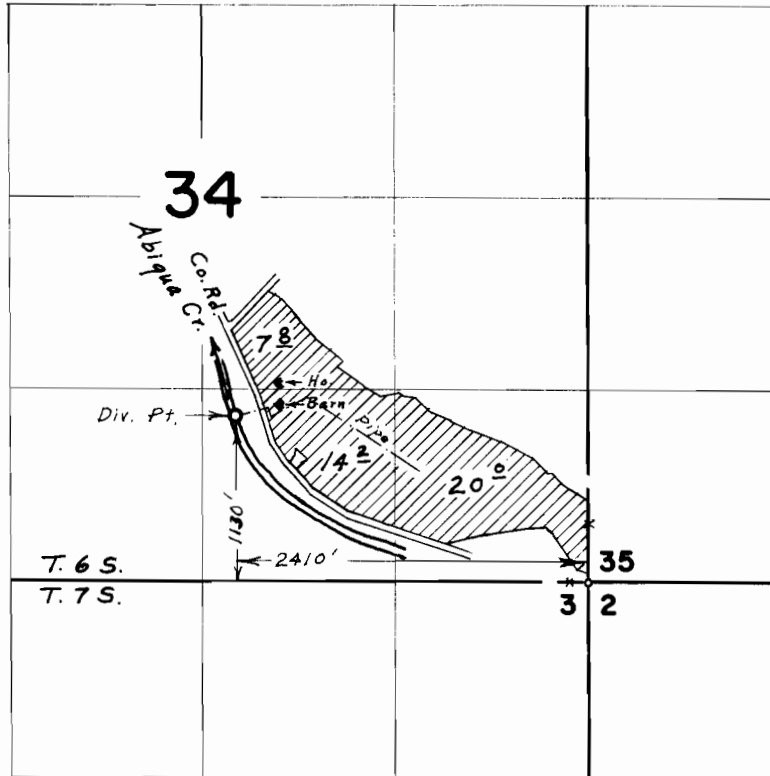

FINAL PROOF SURVEY UNDER

Application No. 37936 Permit No. 28299
IN NAME OF

GERALD B. POTTER

Surveyed *May 9, 1968*, by *L. E. Gould*