


T. 6 S. R. 1 W. W. M.

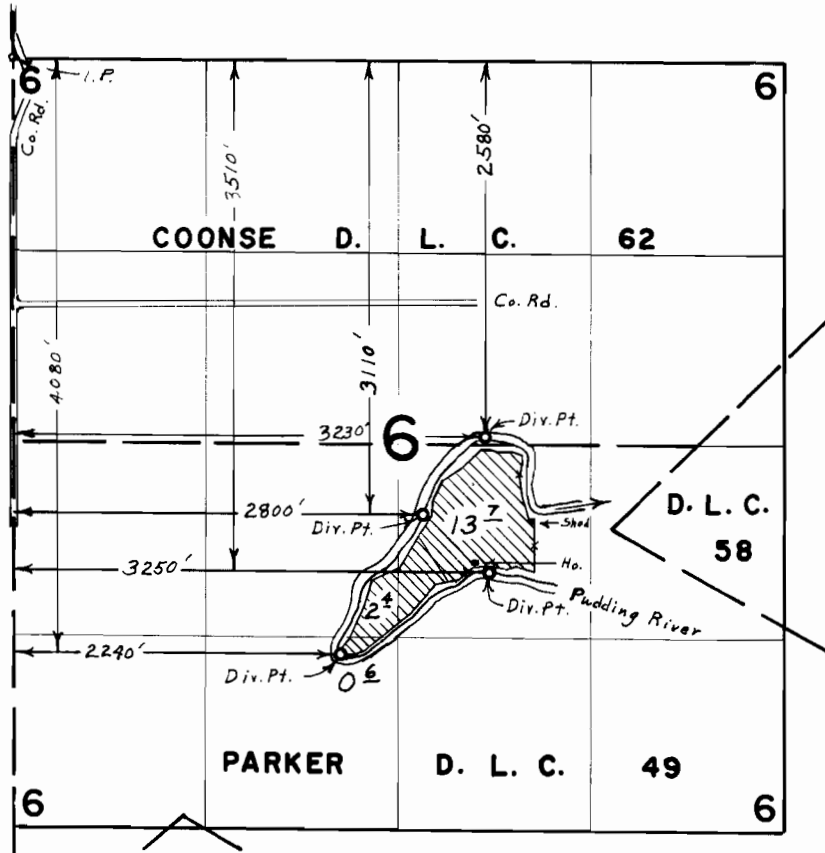

FINAL PROOF SURVEY UNDER

Application No. 38633 Permit No. 28758
IN NAME OF
HOWARD FIELDS

Surveyed April 10, 1968, by L. E. Gould