


T. 7 S. R. 1 W. W. M.

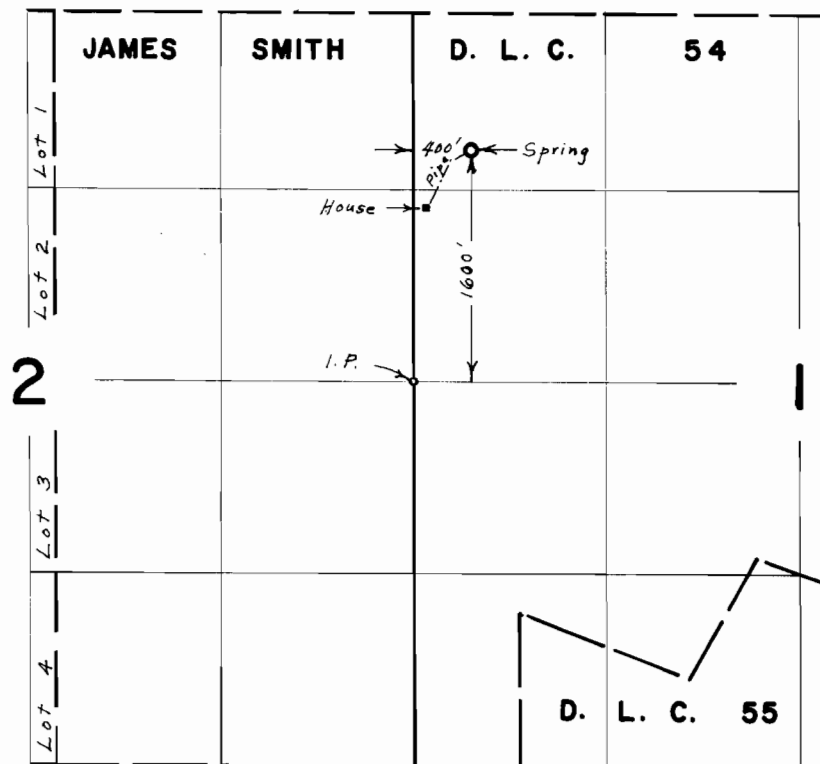

FINAL PROOF SURVEY
UNDER

Application No. 38757 Permit No. 28843
IN NAME OF
EVERETT E. HILL

Surveyed May 9, 1968, by L. E. Gould