


T. 7 S. R. 1 W. W. M.

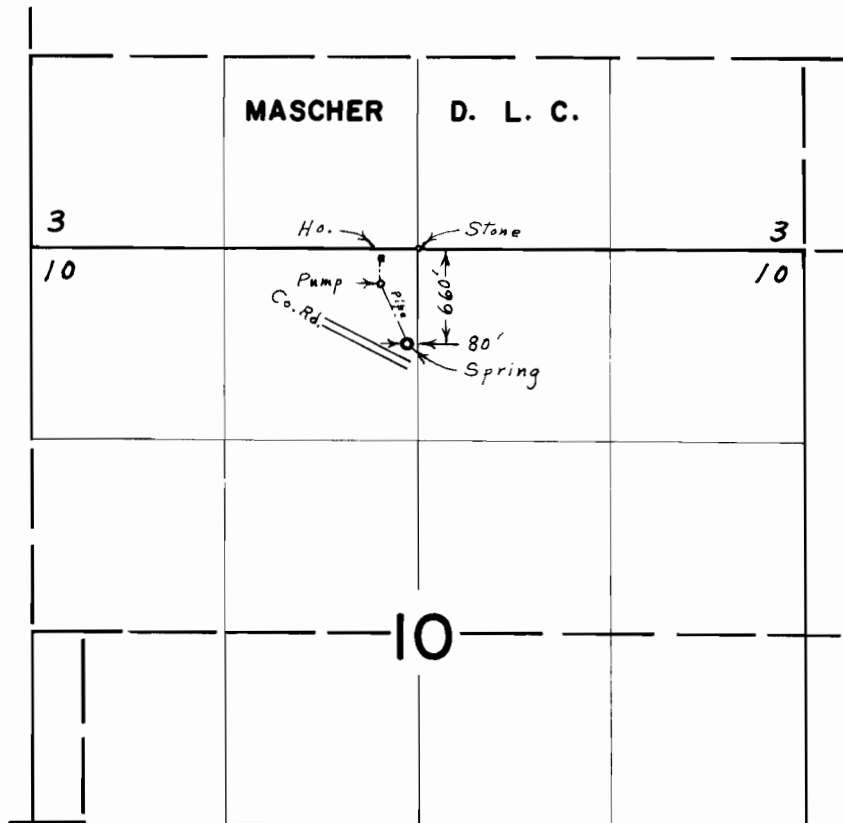

FINAL PROOF SURVEY UNDER

Application No. 43296 Permit No. 32376
IN NAME OF

ORVILLE McDANIELS

Surveyed May 31, 1968, by L. E. Gould.