


# T. 7 S. R. 1 W. W. M.

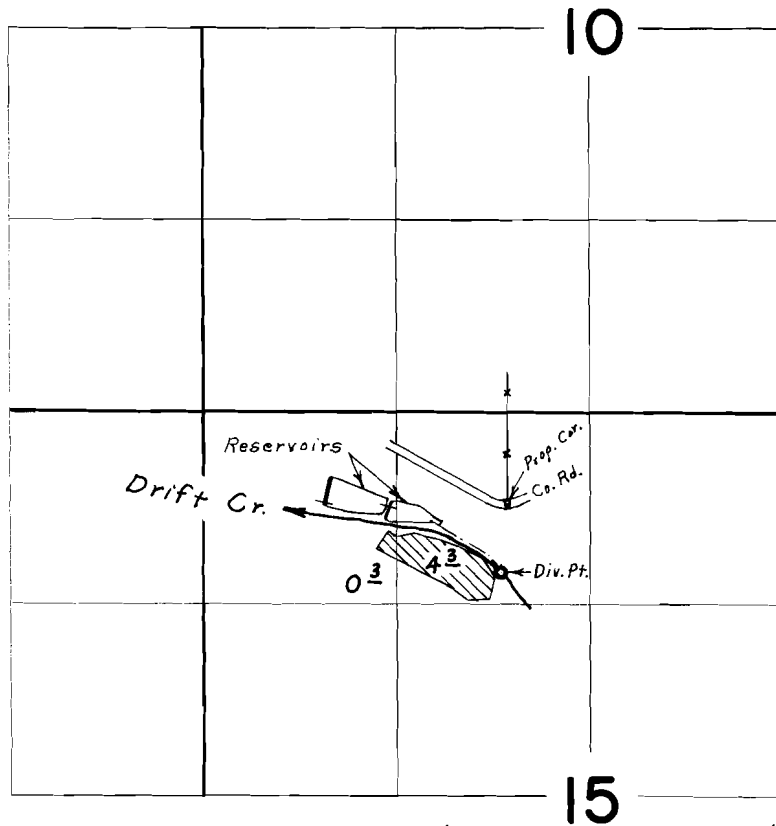

Div. Pts. located: Stream, 373' S. & 2030' E.; Reservoir, 3260' S  
& 830' E.; 3280' S. & 1270' E. all from W.  $\frac{1}{4}$  corner Sec. 10

## FINAL PROOF SURVEY UNDER

R- 39563                      R- 3948  
Application No. 39564 Permit No. 29407  
IN NAME OF

**ERNEST R. CAMPBELL**

Surveyed July 1, 1968, by L. E. Gould