


T. 6 S. R. 1 W. W. M.

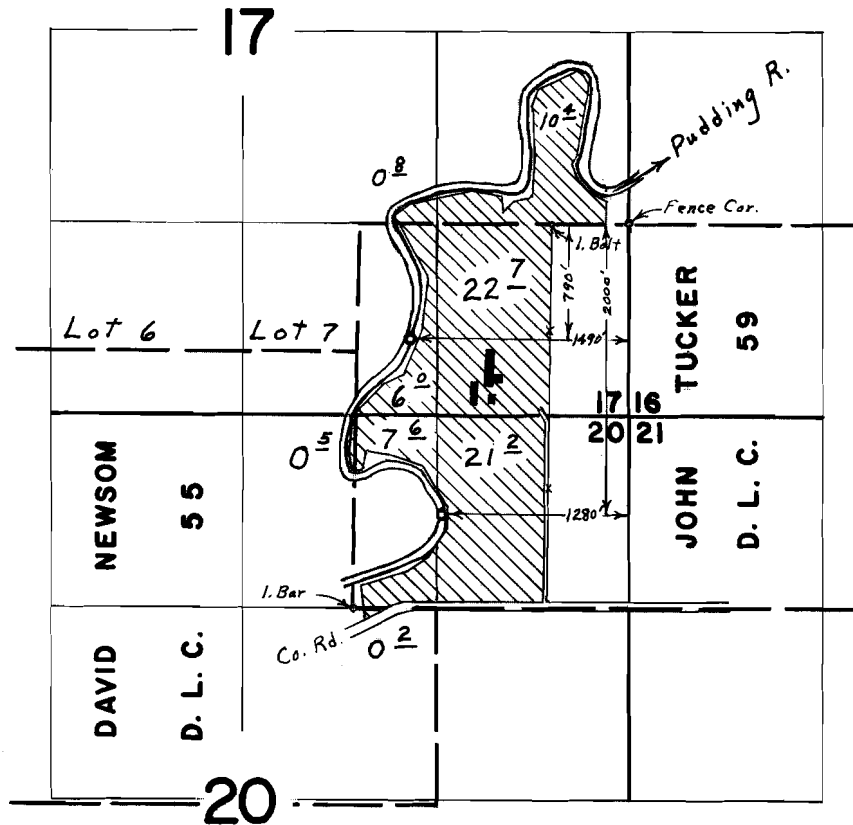

FINAL PROOF SURVEY UNDER

Application No. 39993.. Permit No. 29791..
IN NAME OF

CHARLES FAESSLER

Surveyed *April 11, 1968*, by *L. E. Gould*..