


T. 6 & 7 S. R. 1 E. W. M.

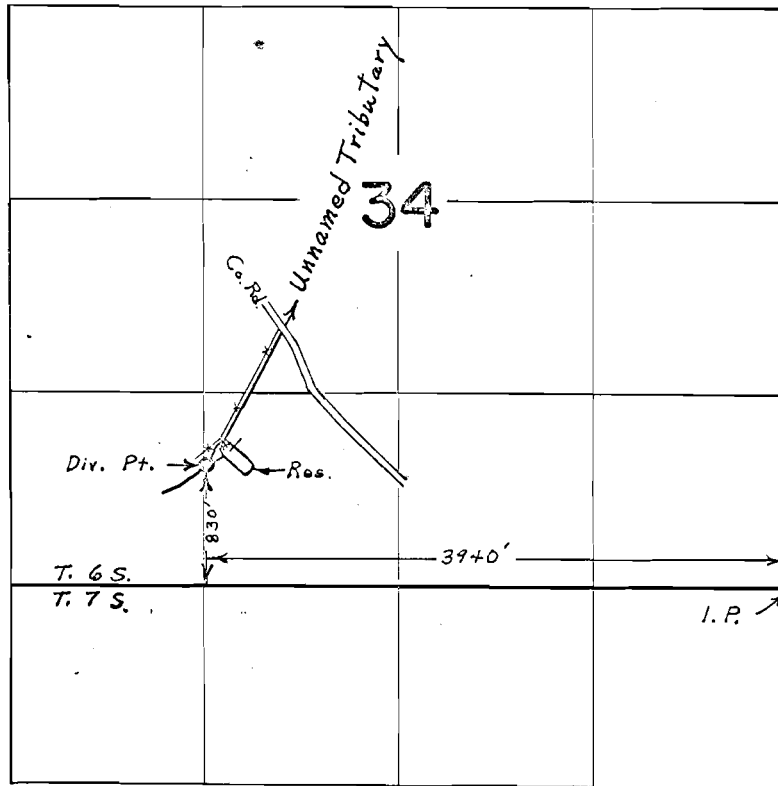

FINAL PROOF SURVEY
UNDER

R-40633 R-4540
Application No. ~~40634~~ Permit No. ~~30244~~
IN NAME OF
W. J. ROBERTS

Surveyed *May 8, 1968*, by *L. E. Gould*.