


*Copy
from file
5-20-68*

T.8S.R.1E.W.M.

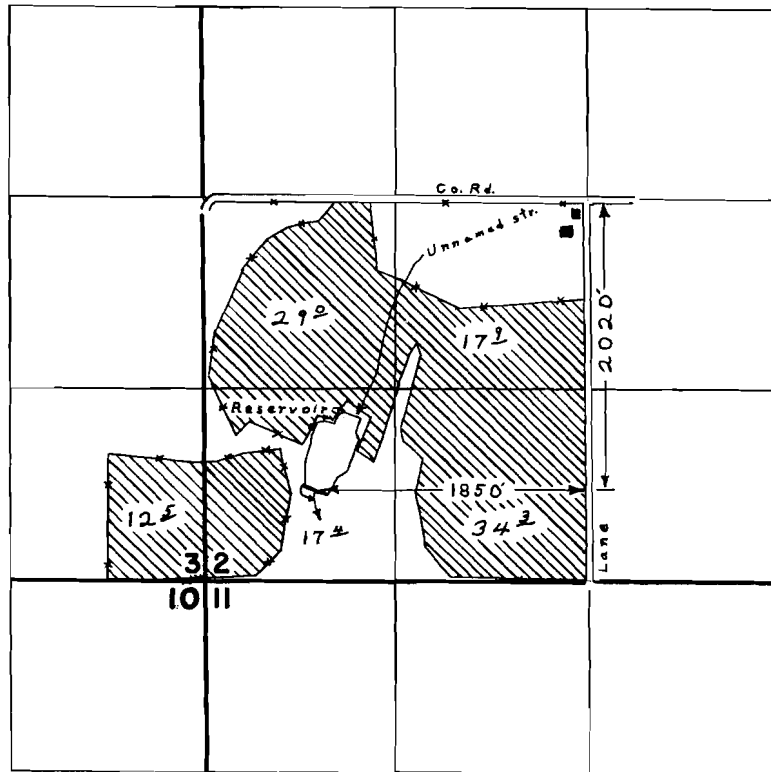

FINAL PROOF SURVEY UNDER

R-40518 R-4565
Application No. 40519 Permit No. 30372
IN NAME OF

**RALPH O. & EDNA M. SOVEREIGN
JACK L. & SANDRA K. SOVEREIGN**

Surveyed **AUG. 16, 1968**, by **L. E. GOULD**