


Copy  
from file  
5-20-68

# T.8S.R.1E.W.M.

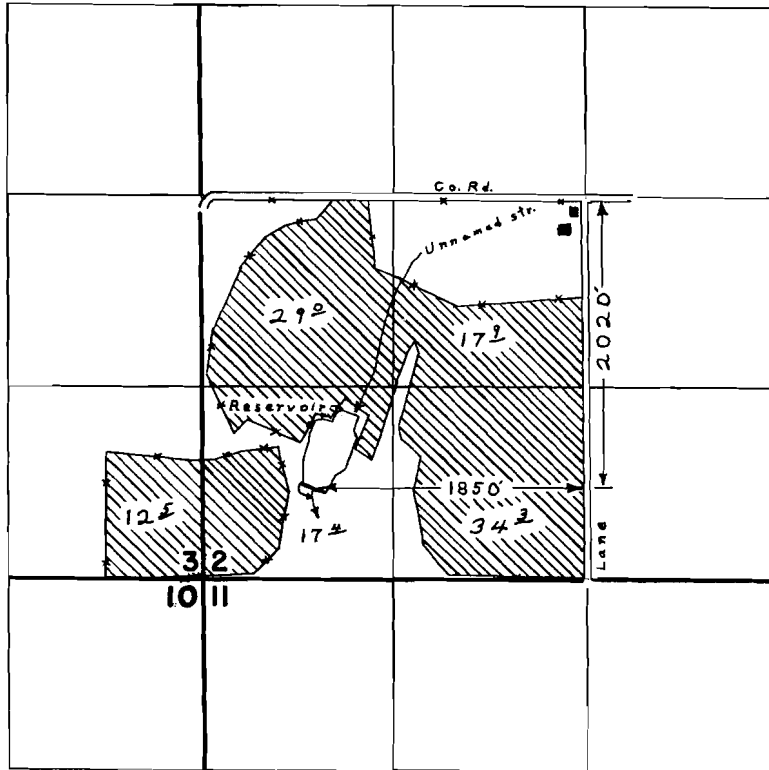

## FINAL PROOF SURVEY UNDER

R-40518                      R-4565  
Application No. 40519      Permit No. 30372  
IN NAME OF

**RALPH O. & EDNA M. SOVEREIGN**  
**JACK L. & SANDRA K. SOVEREIGN**

Surveyed **AUG. 16, 1968**, by **L. E. GOULD**