


T. 6 S. R. 1 W. W. M.

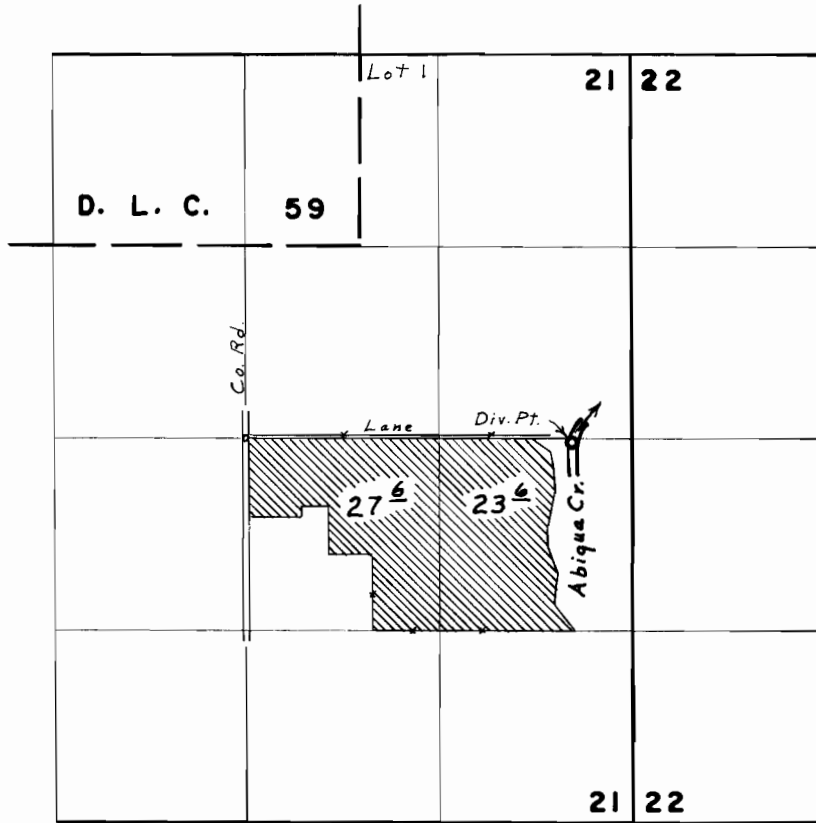

Div. Pt. located 20' S. & 2230' E. from center Sec. 21

FINAL PROOF SURVEY UNDER

Application No. 41945 Permit No. 31459
IN NAME OF

LEROY BEALS

Surveyed *April 12, 1968*, by *L. E. Gould*