


T. 6 S. R. 1 E. W. M.

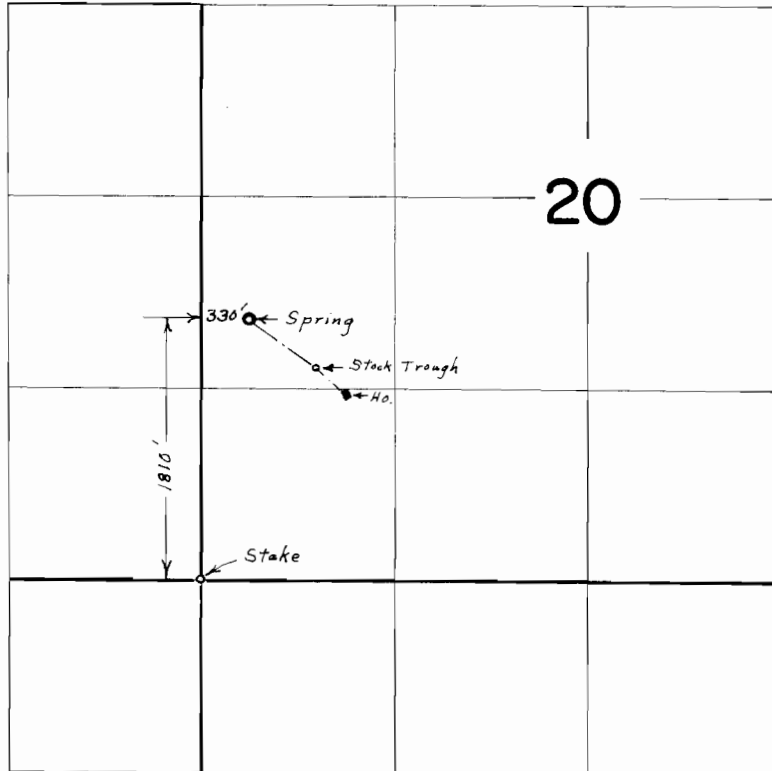

FINAL PROOF SURVEY UNDER

Application No. 42673 Permit No. 31890
IN NAME OF

EDWARD H. HORNER

Surveyed April 25, 1968, by L. E. Gould