


# T. 6 S. R. 1 E. W. M.

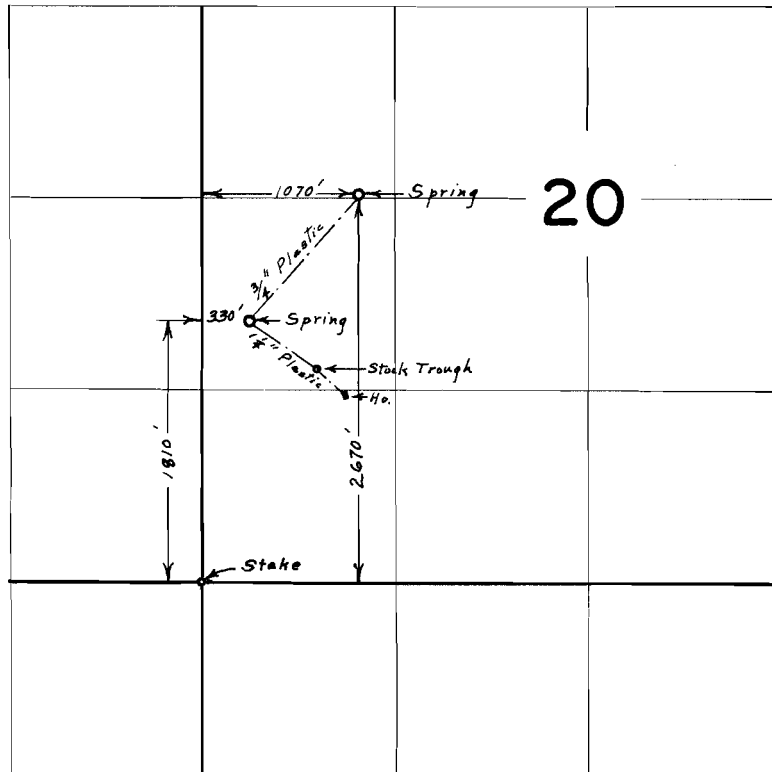

## FINAL PROOF SURVEY UNDER

Application No. 43970 Permit No. 32848  
IN NAME OF

EDWARD HORNER

Surveyed May 31, 1968, by L. E. Gould