


T. 6 S. R. I E. W. M.

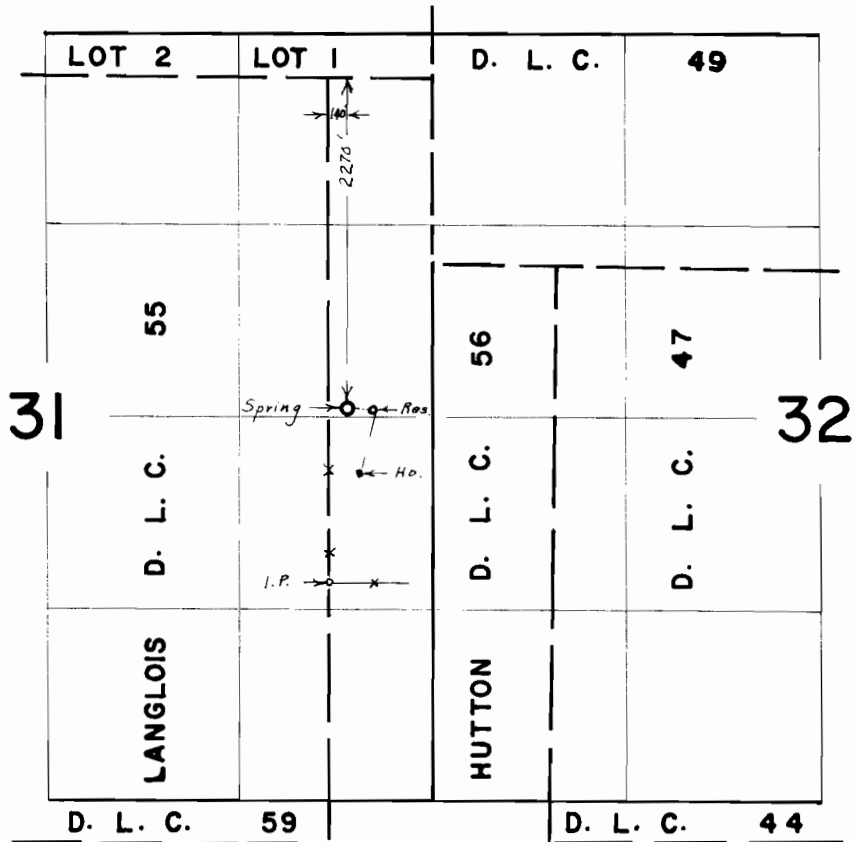

FINAL PROOF SURVEY
UNDER

Application No. **42788** Permit No. **31989**
IN NAME OF

RALPH WICKHAM

Surveyed May 8, 1968, by L. E. Gould