


T. 7 S. R. I W. W. M.

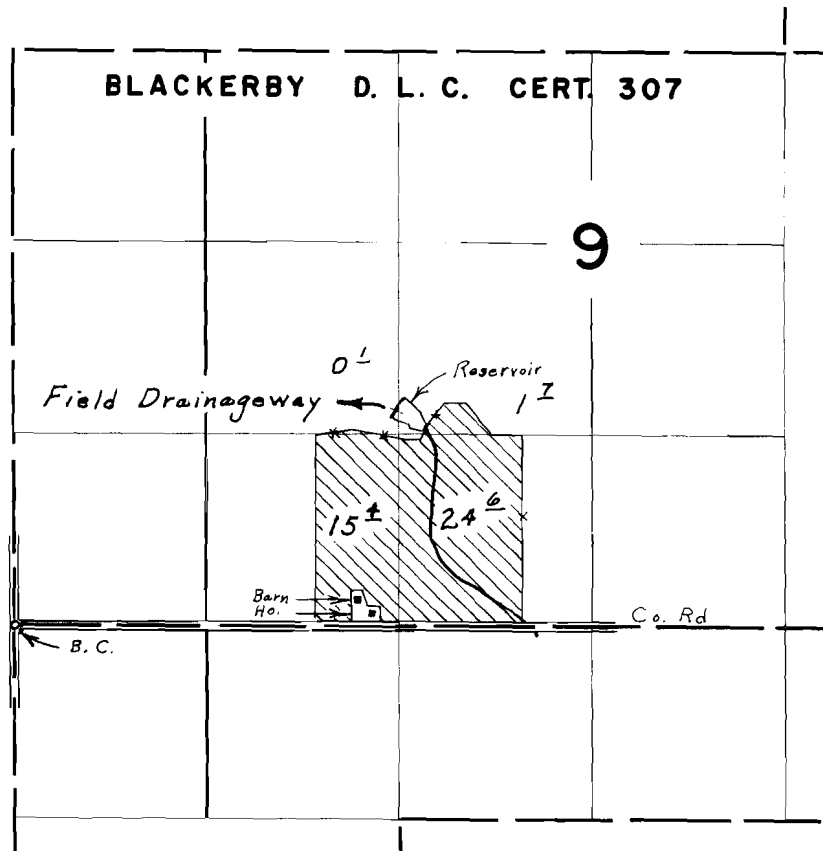

Div. Pt. located 1480' N. & 2620' E. from S.W. cor. Blackerby D.L.C.

FINAL PROOF SURVEY UNDER

R-43062 *R-4902*
Application No. *43063* Permit No. *32175*
IN NAME OF

ERNEST A. KLOPFENSTEIN

Surveyed *June 20, 1968*, by *L. E. Gould*