


# T. 7 S. R. 1 W. W. M.

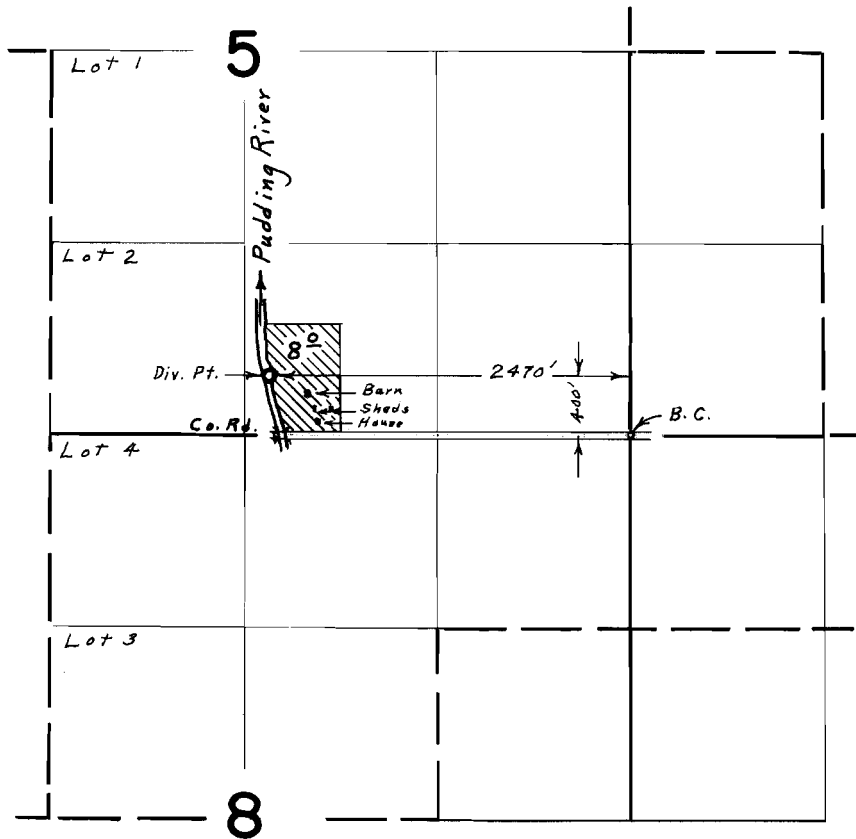

## FINAL PROOF SURVEY UNDER

Application No. 43661 Permit No. 32639  
IN NAME OF

**FRIEDA STADELI**

Surveyed May 10, 1968, by L. E. Gould