


T.6S. R.6W. W.M.

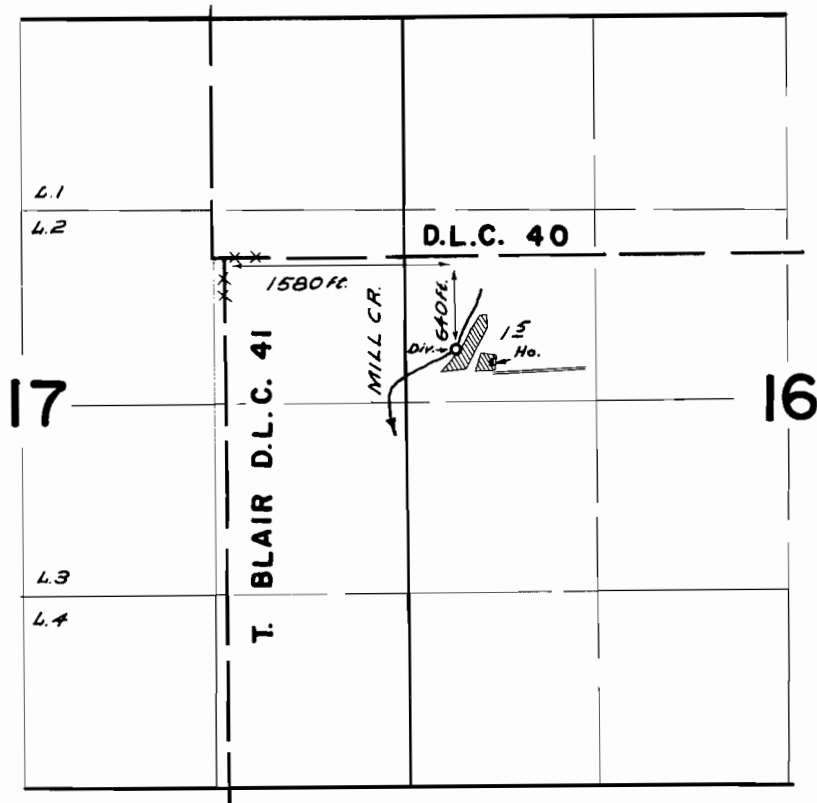

FINAL PROOF SURVEY UNDER

Application No. **38377** Permit No. **28600**
IN NAME OF

FRED C. HURFORD

Surveyed **APR. 26** 1966, by *W. J. [Signature]*