


T. 2 S. R. 39 E. W.M.

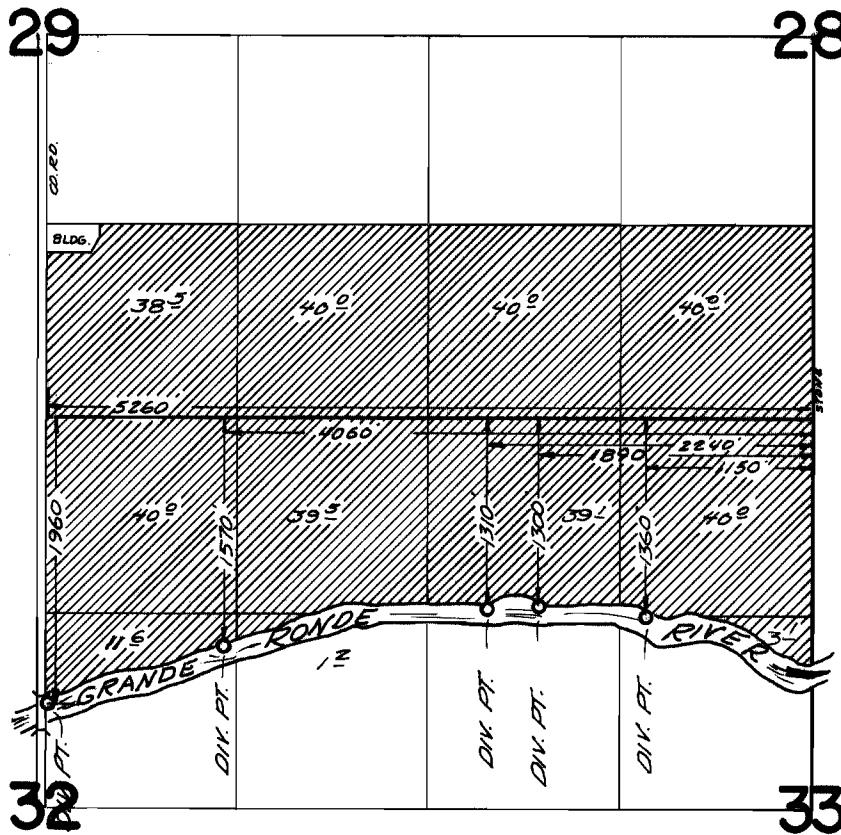

FINAL PROOF SURVEY

UNDER

Application No. 38053 Permit No. 28434
IN NAME OF

EVERETT L. HAMANN

Surveyed Aug. 29, 1968, by V. Garner

1968-E