


T.4S.R.39&40E.W.M.

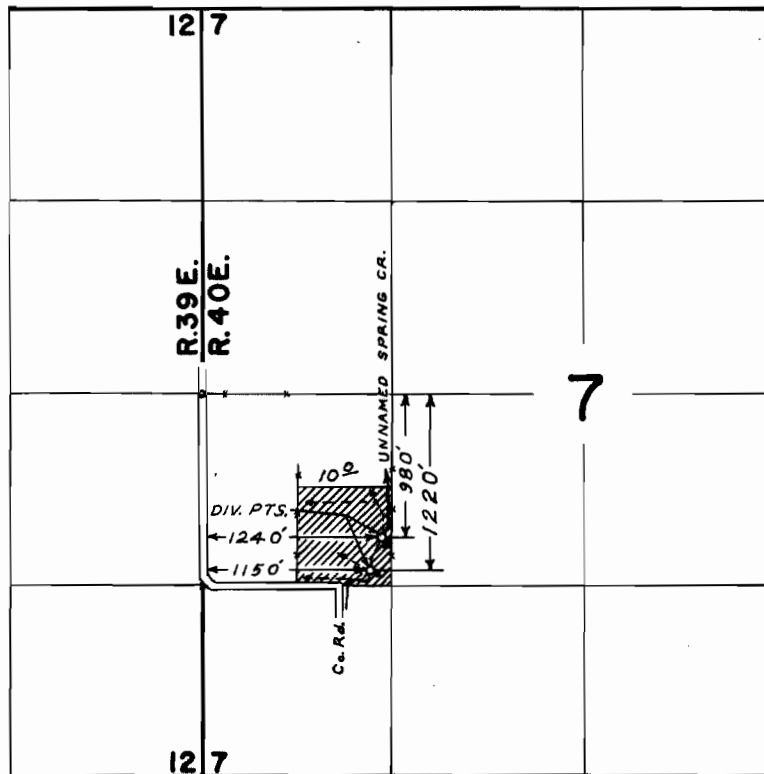

FINAL PROOF SURVEY UNDER

Application No. 38112 Permit No. 28406
IN NAME OF

ELMER CONRAD

Surveyed AUG. 28 1968, by L. E. GOULD