


T.2S.R.3W.W.M.

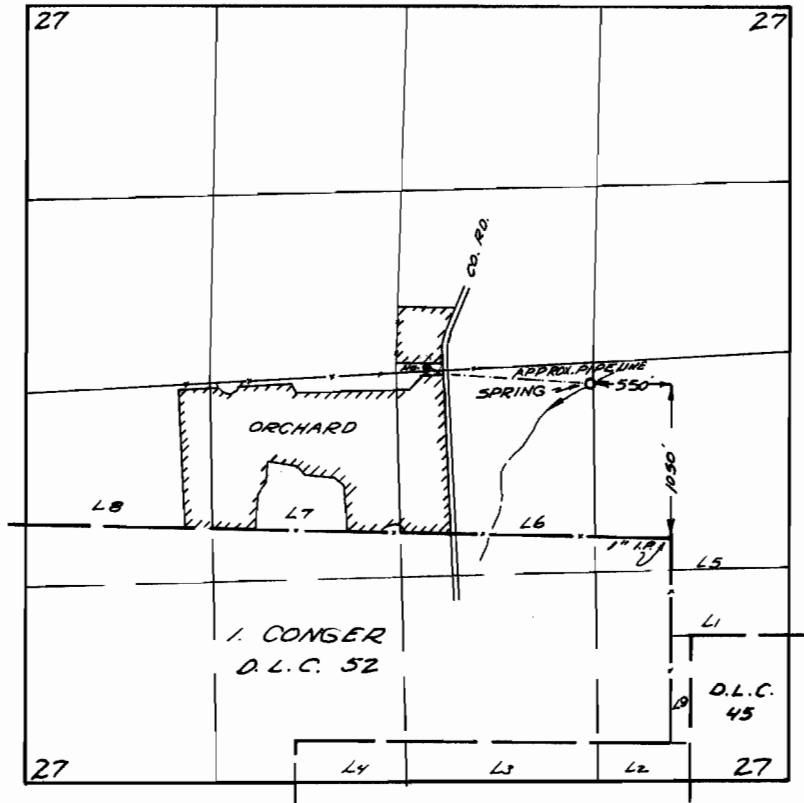

FINAL PROOF SURVEY UNDER

Application No. 33571 Permit No. 26561
IN NAME OF

DONALD F. & JOYCE L. HEIN

Surveyed Sept 7, 1967, by V Garner