


# T. 14 S. R. 7 & 8 W. W.M.

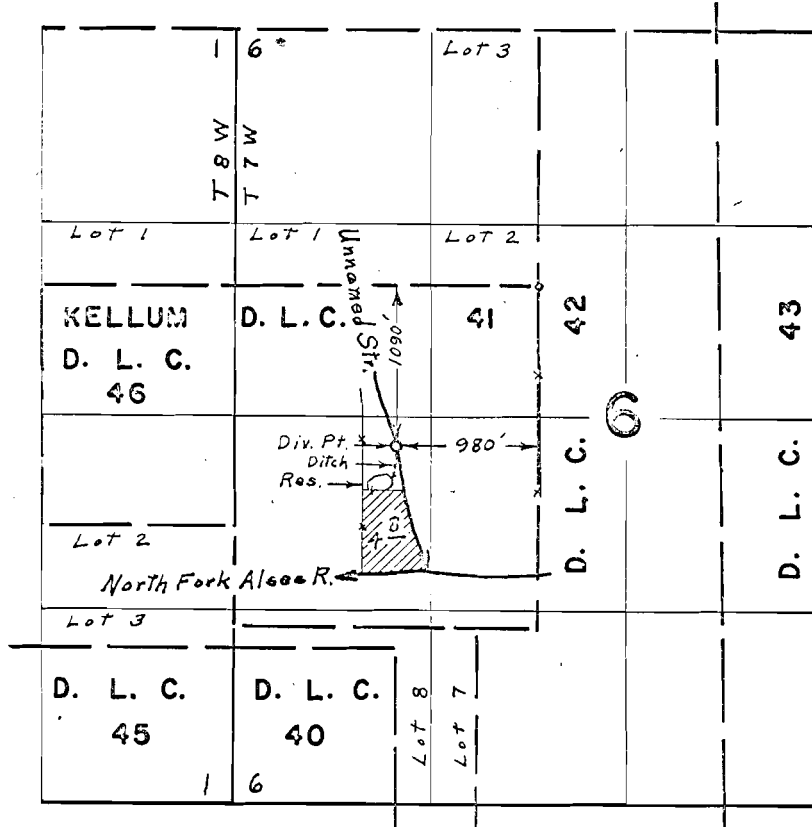

## FINAL PROOF SURVEY UNDER

R-41764 R-4786  
 Application No. 41765 Permit No. 31522  
 IN NAME OF

VEDA N. DALEY McKEE

Surveyed Sept 27, 1968, by L. E. Gould