


T. 4 S. R. 1 E. W. M.

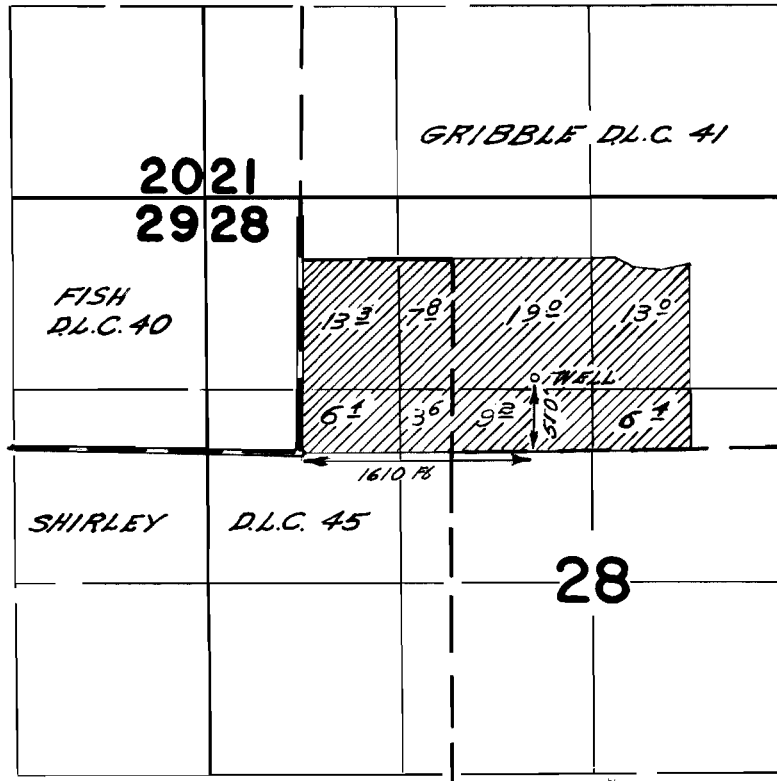

FINAL PROOF SURVEY UNDER

Application No. *G-3972* Permit No. *G-3729*
IN NAME OF

ANTHONY B. CACKA

Surveyed *June 21 1968*, by *W. J. Ruppert*