


T.26S.R.12W.W.M.

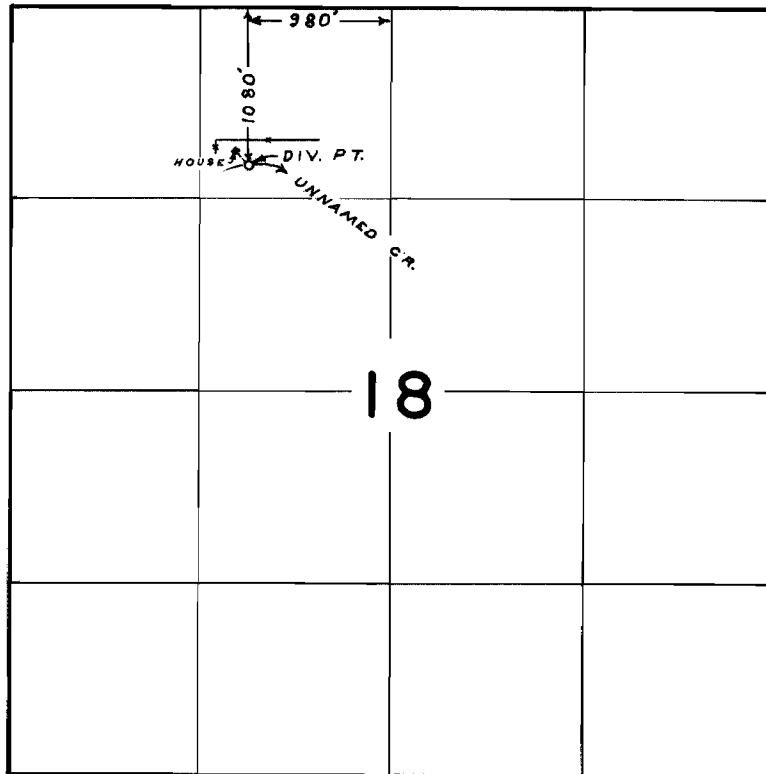

**FINAL PROOF SURVEY**  
UNDER

Application No. 39212 Permit No. 29226  
IN NAME OF

DONALD BERG

Surveyed SEPT. 19 1968, by L. E. GOULD