


T.26S.R.12W.W.M.

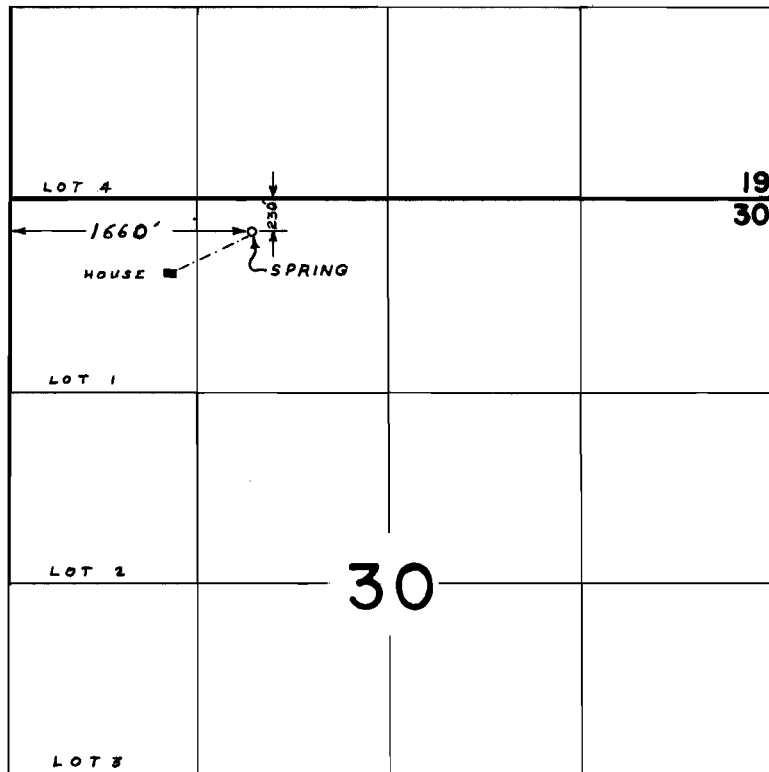

FINAL PROOF SURVEY UNDER

Application No. 40987 Permit No. 30562
IN NAME OF

GRAYDON R. THOM JR.

Surveyed SEPT. 19 1968, by L. E. GOULD