


# T26S.R.13W.W.M.

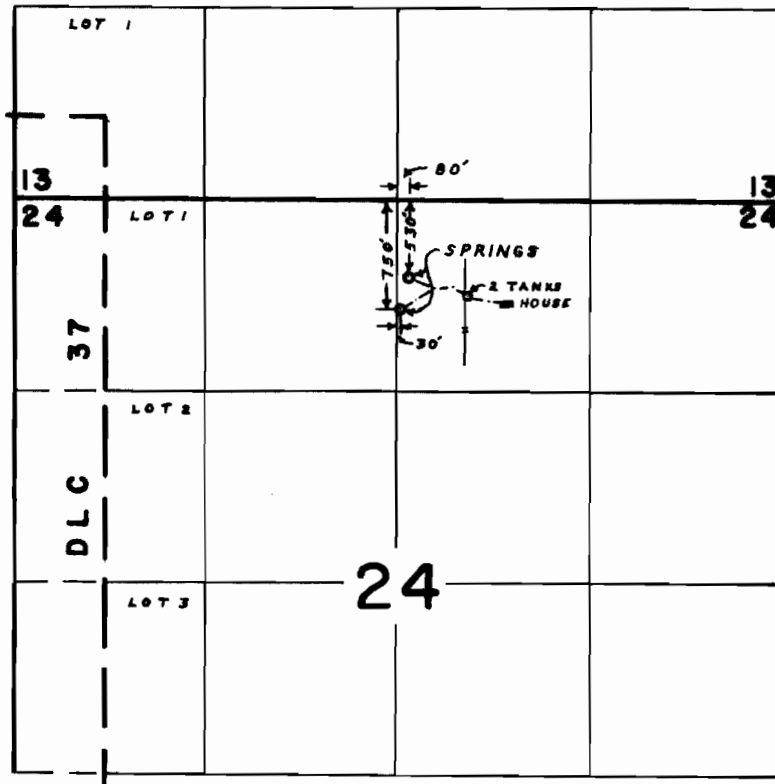

## FINAL PROOF SURVEY UNDER

Application No. 43044 Permit No. 32166  
IN NAME OF

ALLEN M. & ORMA G. YOUNGMAYER

Surveyed SEPT. 18 1968, by L. E. GOULD